

RECEIVED
STATE CORPORATION COMMISSION
7-1-74
1974


STATE OF KANSAS
STATE CORPORATION COMMISSION

Give All Information Completely
Make Required Affidavit
Mail or Deliver Report to:
Conservation Division
State Corporation Commission

P. O. Box 17027
Wichita, Kansas 67217
NORTH

CONSERVATION DIVISION
Wichita, Kansas

WELL PLUGGING RECORD

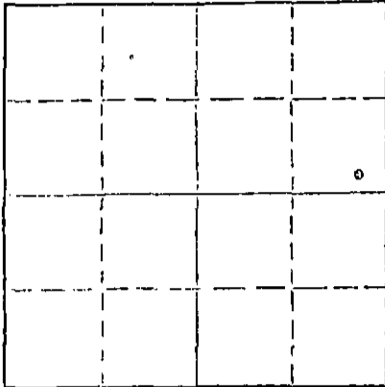

Locate well correctly on above
Section Plat

Edwards County. Sec. 23 Twp. 25 Rge. (E) 16 (W)
Location as "NE/CNW/SE" or footage from lines SE SE NE
Lease Owner D. R. Lauck Oil Company, Inc.
Lease Name Ansel Well No. 1
Office Address 301 S. Broadway, Wichita, Kansas 67202
Character of Well (completed as Oil, Gas or Dry Hole) oil
Date well completed 19
Application for plugging filed 19
Application for plugging approved 19
Plugging commenced May 8 19 74
Plugging completed June 15 19 74
Reason for abandonment of well or producing formation depleted
If a producing well is abandoned, date of last production 19
Was permission obtained from the Conservation Division or its agents before plugging was commenced? YES

Name of Conservation Agent who supervised plugging of this well G. R. Biberstein
Producing formation Depth to top Bottom Total Depth of Well 4735 Feet
Show depth and thickness of all water, oil and gas formations.

OIL, GAS OR WATER RECORDS

CASING RECORD

FORMATION	CONTENT	FROM	TO	SIZE	PUT IN	PULLED OUT
		0	335'	8 5/8"	335'	none
			4733'	5 1/2"	4733'	2276.20

Describe in detail the manner in which the well was plugged, indicating where the mud fluid was placed and the method or methods used in introducing it into the hole. If cement or other plugs were used, state the character of same and depth placed, from feet to feet for each plug set.

Sanded back to 4200' and dumped 5 sacks of cement.
Sun Cementing Company plugged well pumping in 2 sacks of hulls, 10 sacks of gel and 100 sacks of cement.

(If additional description is necessary, use BACK of this sheet)
Name of Plugging Contractor PIPE PULLERS, INC.
Address Box 486, Ellinwood, Kansas 67526

STATE OF KANSAS COUNTY OF BARTON, ss.
Evelyn Roth (employee of owner) or (owner-or-operator) of the above-described

well, being first duly sworn on oath, says: That I have knowledge of the facts, statements, and matters herein contained and the log of the above-described well as filed and that the same are true and correct. So help me God.

(Signature) Evelyn Roth
Ellinwood, Kansas (Address)

SUBSCRIBED AND SWORN TO before me this 28th day of June 19 74

My commission expires Feb. 10, 1975
George A. Meyer Notary Public.

D. R. Lauck Oil Company, Inc.

Ansel #1

SE SE NE Sec. 23-25S-16W
Edwards County Kansas

Commenced: February 23, 1958
Completed: March 12, 1958

Casing Record: 335 ft. 8 5/8" cem. with 250 sacks
4733 ft. 5 1/2" Calcium Chloride 4 sacks
cem. with 125 sacks

Elevation: GR 2057; DF 2060; KB 2062.

Drillers Log

RECEIVED
STATE CORPORATION COMMISSION
APR 23 1974
CONSERVATION DIVISION
Wichita, Kansas

			Tops	Sample	Welex
Shale & sand	40	Heebner	3707-1645	3706-1644	
sand	200	Toronto	3726-1664	3726-1664	
Blue Shale	305	Douglas	3743-1681	3743-1681	
sand	316	Brown Lime	3848-1786	3847-1785	
shale & shells	335	Lansing	3865-1803	3865-1803	
Red Bed, Shale & shells	760	Base Kansas City	4138-2076	4139-2077	
Red Bed & Shells	1046	Conglomerate	4298-2236	4298-2236	
Anhydrite	1060	Cherty sand	4320-2258	4318-2256	
shale & shells	1335	Kinderhook	4340-2278	4338-2276	
shale, Shells & Salt	1690	Viola	4397-2335	4397-2335	
shale & shells	1925	Simpson	4608-2546	4608-2546	
Lime & shale	2130	Arbuckle	4683-2621	4684-2622	
lime	2387	Rotary Total Depth	4733-2671	4735-2673	
Cherty lime	2410				
lime & shale streaks	2415	DST #1 (S)	4293-4334 strong blow. Gas to surface in 38 min. Recov. 85' heavily gas and slightly oil cut mud, 60 ft. heavily oil and gas cut mud; 60' gassy muddy oil ISIP 1520# in 30"; FSIP 1360# in 60"; LFP 40#; FFP 80#;		
Lime & shale	3405	DST #2 (S)	4340-4370; open 1 hr. weak blow 20 min. and died; recov. 31' drilling mud; ISIP 800# in 30 min. FSIP 0# in 60 min. FP 0#.		
Lime	3515				
Shale & Lime	3570				
Lime & shale	3680				
Lime	3745				
Shale & Lime	3850				
Lime	4105				
Lime & shale	4299				
chert & shale	4370				
shale	4397				
Viola	4405				
Lime & chert	4440				
shale-cherty lime	4500				
Lime & shale	4540				
Viola Lime, shale & chert	4555				
Viola	4584				
lime & shale	4615				
lime, shale & sand	4655				
Simpson	4684				
Dolomite	4733	RTD			

D. R. LAUCK OIL COMPANY, INC.

301 SOUTH BROADWAY

WICHITA 2, KANSAS