

STATE OF KANSAS  
STATE CORPORATION COMMISSION  
CONSERVATION DIVISION  
P. O. BOX 17027  
WICHITA, KANSAS 67217

FORM CP-4

WELL PLUGGING RECORD

Edwards County, Sec. 23 Twp. 25 Rge. 16 (E) (W)

Location as "NE/CNW/SW" or footage from lines. C SW NE

Lease Owner D. R. Lauck Oil Co.

Lease Name Ansel #2 Well No. \_\_\_\_\_

Office Address Ellinwood, Kansas 67526

Character of Well (completed as Oil, Gas or Dry Hole) Oil Well

Date well completed June 6, 1959

Application for plugging filed August 27, 1975

Application for plugging approved September 3, 1975


Plugging commenced 9/4/75 1975

Plugging completed 9/12/75 1975

Reason for abandonment of well or producing formation depleted.

If a producing well is abandoned, date of last production August 15, 1975

Was permission obtained from the Conservation Division or its agents before plugging was commenced? yes

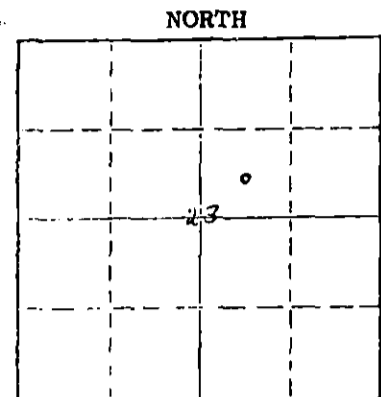

Locate well correctly on above Section Plot

Name of Conservation Agent who supervised plugging of this well Biberstein

Producing formation Sandy Conglomerate Depth to top 4337 Bottom 4341 Total Depth of Well 4386 Feet

P.B.

Show depth and thickness of all water, oil and gas formations.

OIL, GAS OR WATER RECORDS

CASING RECORD

FORMATION	CONTENT	FROM	TO	SIZE	PUT IN	PULLED OUT
Sandy Conglomerate	Oil	4337	4341	8-5/8	347	none
				5 1/2"	4420	3426'

Describe in detail the manner in which the well was plugged, indicating where the mud fluid was placed and the method or methods used in introducing it into the hole. If cement or other plugs were used, state the character of same and depth placed, from \_\_\_\_\_ feet to \_\_\_\_\_ feet for each plug set.

Ran sand to 4200' and loaded hole. Mixed and dumped 5 sacks cement.  
Shot pipe at 3640', 3540', 3441', pulled 105 joints of 5 1/2" casing.  
Pumped well with 3 sacks hulls, 10 sacks gel and 100 sacks cement.

PLUGGING COMPLETE.

(If additional description is necessary, use BACK of this sheet)

Name of Plugging Contractor KELSO CASING PULLING

Address CHASE, KANSAS

STATE OF KANSAS COUNTY OF RICE  
R. DARRELL KELSO (employee of owner) or (owner or operator) of the above-described

well, being first duly sworn on oath, says: That I have knowledge of the facts, statements, and matters herein contained and the log of the above-described well as filed and that the same are true and correct. So help me God.

(Signature) R. Darrell Kelso

CHASE, KANSAS


(Address)

SUBSCRIBED AND SWORN TO before me this 16th day of September, 19 75

My commission expires



Margaret Melcher Notary Public.

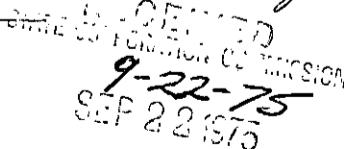

D. R. Lauck Oil Company, Inc.

Ansel #2

C SW NE Sec. 23-25S-16W  
Edwards County, Kansas

Commenced: May 13, 1959

Completed: May 24, 1959

Casing Record: 343' 8 5/8" cem. with 225 sacks  
Calcium Chloride 5 sacks  
4420' 5 1/2" cem. with 600 gals. Latex

Elevation: GR 2063; DF 2065; KB 2067

Drillers Log

		<u>Tops</u>		
		<u>Sample</u>	<u>Welex</u>	
Clay & sand	35	Heebner	3710-1643	3708-1641
sand	223	Toronto	3730-1663	3728-1661
shale	315	Douglas	3748-1681	3746-1679
sand	325	Brown Lime	3852-1785	3850-1783
shale	410	Lansing	3869-1802	3868-1801
red bed	630	Base Kansas City	4142-2075	4140-2073
sand & red bed	700	Conglomerate	4305-2238	4304-2237
red bed & shale	1047	Sandy Conglomerate	4326-2253	4324-2257
Anhydrite	1070	Kinderhook shale	4344-2283	4347-2280
shale, shells & red bed	1450	Viola	4395-2328	4394-2327
shale & shells	1925	Total Depth	4320-2353	4320-2353
shale & lime	2070			
lime & shale	2650	DST #1 (Sun)	4296-4320	open 1 hr; weak blow throughout; recov. 30 ft mud; ISIP 340# in 30 min. FSIP 0# in 30 min.
shale & lime	3350			
Lime & shale	3630			
lime	3750			
shale	3850			
Lime & shale	3880	DST #2 (Sun)	4312-4351	open 1 hr; weak blow throughout; recov. 130 ft slightly oil specked mud; ISIP 1480# in 30 min. FSIP 210# in 30 min. still building; IFP 80# FFP 120#.
Lime	4205			
Lime, shale, chert & sand	4275			
lime & shale	4308			
chert	4330			
chert & shale	4351			
shale	4375			
sand & shale	4420	R.T.D.		

D. R. LAUCK OIL COMPANY, INC.

301 SOUTH E ROADWAY

WICHITA 2, KANSAS

RECEIVED  

AUG 29 1959

COMM. O.C. 101  
WICHITA, KANSAS