


STATE OF KANSAS
STATE CORPORATION COMMISSION

Form CP-4

Give All Information Completely
Make Required Affidavit
Mail or Deliver Report to:
Conservation Division
State Corporation Commission
212 No. Market
Wichita, Kansas

WELL PLUGGING RECORD

NORTH

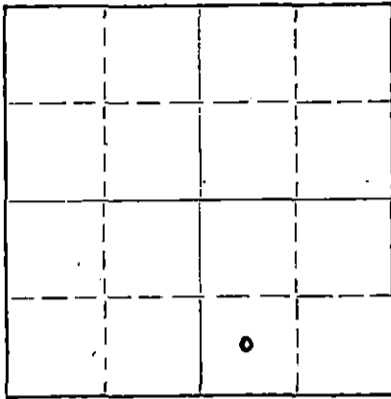

Locate well correctly on above
Section Plat

Ford County, Sec. 28 Twp. 25S Rge. 21W (E) 1980WX) 660' Fr. So
Location as "NE/CNWSW" or footage from lines 150' C SE SW SE
Lease Owner Amarillo Natural Gas Company
Lease Name Schmer Well No. 1
Office Address 305 Bank of the Southwest, Amarillo, Texas 79109
Character of Well (completed as Oil, Gas or Dry Hole) Dry Hole
Date well completed June 28 19 67
Application for plugging filed June 28 19 67
Application for plugging approved June 28 19 67
Plugging commenced June 28 19 67
Plugging completed June 28 19 67
Reason for abandonment of well or producing formation Dry Hole

If a producing well is abandoned, date of last production None 19
Was permission obtained from the Conservation Division or its agents before plugging was commenced? Yes

Name of Conservation Agent who supervised plugging of this well _____
Producing formation _____ Depth to top _____ Bottom _____ Total Depth of Well 4290 Feet
Show depth and thickness of all water, oil and gas formations.

OIL, GAS OR WATER RECORDS

CASING RECORD

FORMATION	CONTENT	FROM	TO	SIZE	PUT IN	PULLED OUT
Surface		0	573	8-5/8"	573	None

Describe in detail the manner in which the well was plugged, indicating where the mud fluid was placed and the method or methods used in introducing it into the hole. If cement or other plugs were used, state the character of same and depth placed, from _____ feet to _____ feet for each plug set.

Plug @ 570' w/35 sacks cement and plug 30' to surface w/15 sacks cement.

RECEIVED
STATE CORPORATION COMMISSION
JUL 3 1967
CONSERVATION DIVISION
Wichita, Kansas

(If additional description is necessary, use BACK of this sheet)

Name of Plugging Contractor Mahoney Drilling Co., Inc.
Address P. O. Box 1257, Liberal, Kansas 67901

STATE OF Texas, COUNTY OF Potter, ss.
L. E. Geoffroy (~~operator~~) of the above-described well, being first duly sworn on oath, says: That I have knowledge of the facts, statements, and matters herein contained and the log of the above-described well as filed and that the same are true and correct. So help me God.

(Signature) [Signature]
305 Bank of the Southwest, Amarillo, Texas 79109
(Address)

SUBSCRIBED AND SWORN TO before me this 30th day of June, 1967

My commission expires 6-1-69
[Signature] Notary Public.
Potter County, Texas

