

WELL PLUGGING RECORD

Give All Information Completely  
Make Required Affidavit  
Mail or Deliver Report to:  
Conservation Division  
State Corporation Commission  
211 No. Broadway  
Wichita, Kansas

Ford County, Sec. 33 Twp. 25 Rge. 21 (E) W (W)

Location as "NE/CNW&SW&" or footage from lines. ~~E SW~~ ~~E SE~~ ~~E NE~~ C SE NE

Lease Owner Mack Oil Company

Lease Name Buttler Well No. 1

Office Address Duncan, Oklahoma

Character of Well (completed as Oil, Gas or Dry Hole)

Date well completed 19

Application for plugging filed 19

Application for plugging approved 19


Plugging commenced 8-19-63 19

Plugging completed 8-21-63 19

Reason for abandonment of well or producing formation Depleted.

If a producing well is abandoned, date of last production 19

Was permission obtained from the Conservation Division or its agents before plugging was commenced? Yes

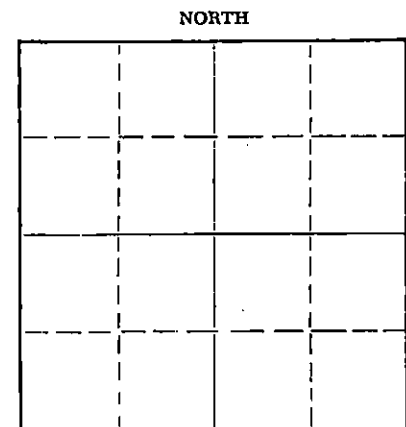

Locate well correctly on above Section Plat

Name of Conservation Agent who supervised plugging of this well Hugh Scott

Producing formation Depth to top Bottom Total Depth of Well 4880 Feet

Show depth and thickness of all water, oil and gas formations.

OIL, GAS OR WATER RECORDS

CASING RECORD

FORMATION	CONTENT	FRD-1	TO	SIZE	PUT IN	PULLED OUT
				8-5/8"	268'	None
				<del>XXXXX</del>		
				4-1/2"	4880'	3826'

Describe in detail the manner in which the well was plugged, indicating where the mud fluid was placed and the method or methods used in introducing it into the hole. If cement or other plugs were used, state the character of same and depth placed, from feet to feet for each plug set.

Checked hole to 4776', sanded hole to 4700' and dumped 5 sacks of cement @ 4700' with dump bailer. Pulled 4 1/2" casing to 500' and pumped 25 sacks of cement. Pulled 4 1/2" casing to 250' and pumped 25 sacks of cement. Pulled balance of 4 1/2" casing, mudded to 50', set rock bridge to 40' and ran 15 sacks of cement to base of cellar.

PLUGGING COMPLETE.

RECEIVED  
STATE CORPORATION COMMISSION

SEP 24 1963

9-24-63

CONSERVATION DIVISION  
Wichita, Kansas

Name of Plugging Contractor KNIGHT CASING PULLING COMPANY  
Address CHASE, KANSAS

STATE OF KANSAS COUNTY OF RICE ss. Noel J. Knight

(employee or owner) or (owner or operator) of the above-described well, being first duly sworn on oath, says: That I have knowledge of the facts, statements, and matters herein contained and the log of the above-described well as filed and that the same are true and correct. So help me God.

(Signature) Noel J. Knight  
Chase, Kansas

(Address)

SUBSCRIBED AND SWORN TO before me this 26th day of August, 1963

My commission expires May 20, 1964 Milton J. Volin Notary Public.