

STATE OF KANSAS
STATE CORPORATION COMMISSION

Form CP-4

WELL PLUGGING RECORD

Give All Information Completely
Make Required Affidavit
Mail or Deliver Report to:
Conservation Division
State Corporation Commission
211 No. Broadway
Wichita, Kansas

Ford County. Sec. 33 Twp. 25S Rge. 21 (X) W (W)

Location as "NE/CNWKSWSW" or footage from lines 660' FROM N, 1980' FROM E

Lease Owner Amarex, Inc.

Lease Name Butler Well No. 2

Office Address c/o Malonee-Mahoney Drlg. Co., Box 1257, Liberal, Kan. 67901

Character of Well (completed as Oil, Gas or Dry Hole) OIL

Date well completed 6/10 1966

Application for plugging filed 4/12 1971

Application for plugging approved 4/13 1971


Plugging commenced 4/30/ 1971

Plugging completed 5/3/ 1971

Reason for abandonment of well or producing formation NO PRODUCTION

If a producing well is abandoned, date of last production 5/1 1970

Was permission obtained from the Conservation Division or its agents before plugging was commenced? YES

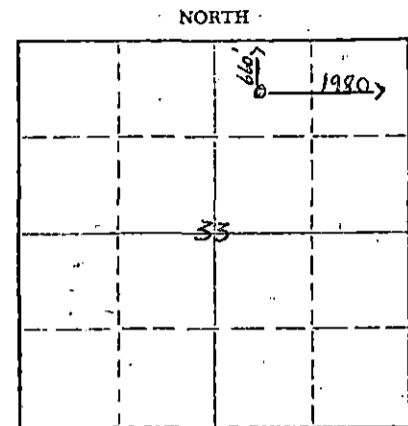

Locate well correctly on above Section Plat

Name of Conservation Agent who supervised plugging of this well ED EVES

Producing formation LANSING KANSAS CITY Depth to top 4160 Bottom 4268 Total Depth of Well 4268 Feet

Show depth and thickness of all water, oil and gas formations.

OIL, GAS OR WATER RECORDS

CASING RECORD

FORMATION	CONTENT	FROM	TO	SIZE	PUT IN	PULLED OUT

Describe in detail the manner in which the well was plugged, indicating where the mud fluid was placed and the method or methods used in introducing it into the hole. If cement or other plugs were used, state the character of same and depth placed, from _____ feet to _____ feet for each plug set.

Mix 20 sks. cement to plug perfs. Stop plug at 3,900'.

Pump 35 sks. cement at 200' to 100'.

Put 15 sks. cement at 45' to 0'.

RECEIVED
STATE CORPORATION COMMISSION
MAY 11 1971
CONSERVATION DIVISION
Wichita, Kansas

(If additional description is necessary, use BACK of this sheet)
Name of Plugging Contractor SARGENTS CASING PULLING SERVICE
Address P.O. Box 506, Liberal, Kansas 67901


STATE OF KANSAS, COUNTY OF SEWARD, ss.

CHESTER A. NORDLING (~~XXXXXXXXXXXX~~ owner or operator) of the above-described

well, being first duly sworn on oath, says: That I have knowledge of the facts, statements, and matters herein contained and the log of the above-described well as filed and that the same are true and correct. So help me God SARGENTS CASING PULLING SERVICE

(Signature) Chester A. Nordling, Partner
Box 506, Liberal, Kansas 67901
(Address)

Subscribed and sworn to before me this 7th day of May, 1971

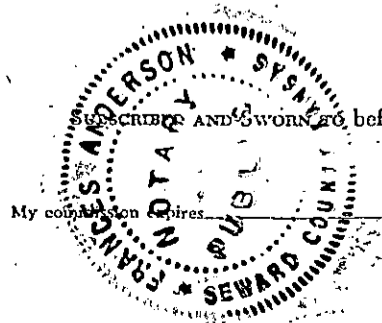

My commission expires _____

FRANCES ANDERSON, NOTARY PUBLIC
MY COMMISSION EXPIRES MAY 7, 1972

Notary Public.

Well # 2
NW 1/4
Sec. 33-25S-21W
Ford County, Kansas

Set 2-5/8" @ 206' 20# 175 Sx Cement
Cement Circulated
Set 4-1/2" @ 4268' NB 100 Sx Cement

Clay-Shale
Shale
Shale-Anhydrite
Shale
Shale-Lime
TD

0-207
207-361
361-1637
1637-2180
2180-4268
4268

This is a true and exact copy of the formation taken
From the Daily Drilling Reports.

T. W. Mahoney
T. W. Mahoney, President

State of KANSA Kansas
County of Seward

XXXX Sworn to before me this 10 of June, 1966

George W. Carnahan Jr
George W. Carnahan, Jr.
Notary Public

My Commission expires January 24, 1968

RECEIVED
STATE CORPORATION COMMISSION
MAY 11 1971
CONSERVATION DIVISION
Wichita, Kansas