


STATE OF KANSAS  
STATE CORPORATION COMMISSION

WELL PLUGGING RECORD

Give All Information Completely  
Make Required Affidavit  
Mail or Deliver Report to:  
Conservation Division  
State Corporation Commission  
211 No. Broadway  
Wichita, Kansas

Ford County, Sec. 35 Twp. 25 Rge. 21W(E) (W)  
Location as "NE/CNW%SW%" or footage from lines NW NW NW  
Lease Owner Bennett & Roberts Drilling Co.  
Lease Name Rinker Well No. 1  
Office Address Russell, Ks.  
Character of Well (completed as Oil, Gas or Dry Hole) Dry Hole  
Date well completec 7/9 19 57  
Application for plugging filed 7/8 - verbally 19 57  
Application for plugging approved 7/8 - verbally 19 57  
Plugging commencec 7/9 19 57  
Plugging completed 7/9 19 57  
Reason for abandonment of well or producing formation Dry Hole

NORTH

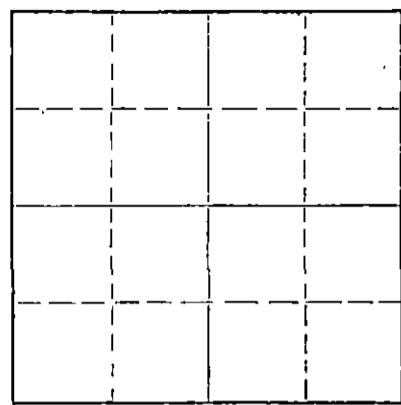

Locate well correctly on above  
Section Plat

If a producing well s abandoned, date of last production 19  
Was permission obtained from the Conservation Division or its agents before plugging was commenced? Yes

Name of Conservation Agent who supervised plugging of this wel M. A. Rives  
Producing formation Depth to top Bottom Total Depth of Well 4900 Feet  
Show depth and thickness of all water, oil and gas formations.

OIL, GAS OR WATER RECORDS

CASING RECORD

FORMATION	CONTENT	FROM	TO	SIZE	PUT IN	PULLED OUT
				8 5/8"	372'	None

Describe in detail the manner in which the well was plugged, indicating where the mud fluid was placed and the method or methods used in introducing it into the hole. If cement or other plugs were used, state the character of same and depth placed, from feet to feet for each plug set.

Heavy mud to 365', 1 1/2 sacks hulls, plug and 20 sacks cement through pipe. Heavy mud to 35', 2 sack hulls, plug #2, 2 sack hulls and 10 sacks cement to bottom of cellar.

(If additional description is necessary, use BACK of this sheet)

Name of Plugging Contractor  
Address

STATE OF KANSAS, COUNTY OF RUSSELL, ss.  
Harold Wurst (employee of owner) or (owner or operator) of the above-described well, being first duly sworn on oath, says: That I have knowledge of the facts, statements, and matters herein contained and the log of the above-described well as filed and that the same are true and correct. So help me God.

(Signature) Harold Wurst  
Russell, Ks.  
(Address)

SUBSCRIBED AND SWORN to before me this 12th day of July, 19 57

My commission expires 6/17/58

Notary Public.

PLUGGING  
FILE SEC 35 T 25 R 21W  
BOOK PAGE 27 LINE 34

RECEIVED  
STATE CORPORATION COMMISSION

JUL 15 1957  
CONSERVATION DIVISION  
Wichita, Kansas

Bennett & Roberts Drilling Co.  
Rinker #1

NW NW NW Sec. 35-25-21W  
Ford County, Kansas

RTD 4900'

3 5/8" Set @ 372' w/275 sacks cement

Commenced 6/14/57  
Completed 7/9/57

Top Soil & Clay	50
Shale & Shells	125
Sand	270
Shale, Gray	345
Blue Shale	372
Shale	540
Shale & Shells	670
Sand	700
Shale	740
Shale & Shells & Red Bed	830
Shale & Red Bed	940
Sand	1010
Shale & Shells	1435
Anhydrite	1460
Shale & Shells	2285
Shale & Lime streaks	2390
Shale & Lime	2640
Lime	2675
Lime & Shale	2795
Lime, Shale & Sand	2880
Lime & Shale	3425
Shale & Lime Streaks	3474
Lime & Shale	3835
Lime	3866
Lime & Shale	3990
Lime & Shale & Junk	4010
Lime & Shale	4114
Lime	4219
Lime & Shale	4285
Lime	4645
Lime & Shale	4804
Lime & Chert	4815
Lime	4820
Cherty Lime	4857
Lime & Chert	4900

STATE OF KANSAS)  
RUSSELL COUNTY ) SS.

I hereby certify that the above information is true and correct to  
the best of my knowledge.

BENNETT & ROBERTS DRILLING CO.

By John R. Truwin

Subscribed and sworn to before me this 12th day of July, 1957.

Clara Hummel  
Notary Public

My Commission Expires 6/17/58

RECEIVED  
STATE CORPORATION COMMISSION

JUL 15 1957

CONSERVATION DIVISION  
Wichita, Kansas

PLUGGING  
FILE SEC. 35 T. 25 R. 21W  
BOOK PAGE 27 LINE 31