


Give All Information Completely
Make Required Affidavit
Mail or Deliver Report to:
Conservation Division
State Corporation Commission
211 No. Broadway
Wichita, Kansas

WELL PLUGGING RECORD

Ford County, Sec. 34 Twp. 25 Rge. 21 (E) W (W)
C NW SW

Location as "NE/CNW/SW" or footage from lines _____
Lease Owner Mack Oil Company
Lease Name Torline Well No. 1
Office Address Duncan, Oklahoma
Character of Well (completed as Oil, Gas or Dry Hole) _____
Date well completed _____ 19____
Application for plugging filed _____ 19____
Application for plugging approved _____ 19____
Plugging commenced 8-22-63 _____ 19____
Plugging completed 8-25-63 _____ 19____
Reason for abandonment of well or producing formation Depleted.

NORTH

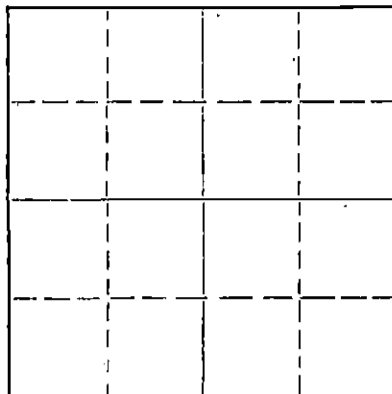

Locate well correctly on above
Section Plat

If a producing well is abandoned, date of last production _____ 19____
Was permission obtained from the Conservation Division or its agents before plugging was commenced? yes

Name of Conservation Agent who supervised plugging of this well Hugh Scott
Producing formation _____ Depth to top _____ Bottom _____ Total Depth of Well 4785 Feet
Show depth and thickness of all water, oil and gas formations.

OIL, GAS OR WATER RECORDS

CASING RECORD

FORMATION	CONTENT	FROM	TO	SIZE	PUT IN	PULLED OUT
				8-5/8"	193'	None
				4-1/2"	4786'	3430'

Describe in detail the manner in which the well was plugged, indicating where the mud fluid was placed and the method or methods used in introducing it into the hole. If cement or other plugs were used, state the character of same and depth placed, from _____ feet to _____ feet for each plug set.

Checked hole to 4777', sanded to 4700' and dumped 5 sacks of cement @ 4700' with dump bailer. Pulled 4 1/2" casing to 500' and pumped 25 sacks of cement @ 500'. Pulled 4 1/2" casing to 175' and pumped 25 more sacks of cement. Pulled balance of 4 1/2" casing, mudded to 50', set rock bridge to 40' and ran 15 sacks of cement to base of cellar.

RECEIVED
STATE CORPORATION COMMISSION

SEP 24 1963
9-24-63
CONSERVATION DIVISION
Wichita, Kansas

PLUGGING COMPLETE.

(If additional description is necessary, use BACK of this sheet)

Name of Plugging Contractor Knight Casing Pulling Company
Address Chase, Kansas

STATE OF Kansas COUNTY OF Rice, ss.
Noel J. Knight (employee of owner) or (owner or operator) of the above-described well, being first duly sworn on oath, says: That I have knowledge of the facts, statements, and matters herein contained and the log of the above-described well as filed and that the same are true and correct. So help me God.

(Signature) Noel J. Knight
Chase, Kansas
(Address)

SUBSCRIBED AND SWORN TO before me this 26th day of August, 1963

Milton J. Volin
Notary Public.

My commission expires May 20, 1964