


STATE OF KANSAS
STATE CORPORATION COMMISSION

Give All Information Completely
Make Required Affidavit
Mail or Deliver Report to:
Conservation Division
State Corporation Commission
211 No. Broadway
Wichita, Kansas

WELL PLUGGING RECORD

Ford County, Sec. 7 Twp. 25 Rge. (E) 23(W)

Location as "NE/CNW/SW" or footage from lines. NENENE
Lease Owner D E Dunne, Jr
Lease Name Cobb Well No. 1
Office Address 1005 Central, Wichita, Kansas
Character of Well (completed as Oil, Gas or Dry Hole) dry hole
Date well completed 4-29 1957
Application for plugging filed 4-29 1957
Application for plugging approved 4-29 1957
Plugging commenced 4-29 1957
Plugging completed 4-29 1957
Reason for abandonment of well or producing formation dry

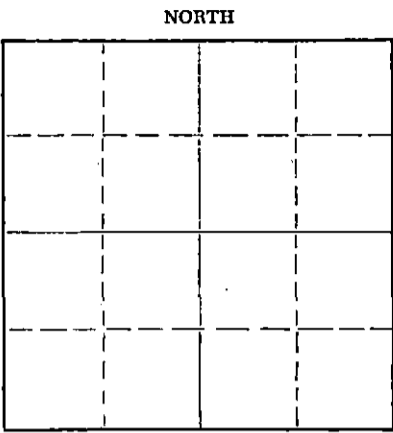

Locate well correctly on above Section Plat

If a producing well is abandoned, date of last production 19
Was permission obtained from the Conservation Division or its agents before plugging was commenced? yes

Name of Conservation Agent who supervised plugging of this well M A Rives
Producing formation _____ Depth to top _____ Bottom _____ Total Depth of Well 4801 Feet
Show depth and thickness of all water, oil and gas formations.

OIL, GAS OR WATER RECORDS

CASING RECORD

FORMATION	CONTENT	FROM	TO	SIZE	PUT IN	PULLED OUT

Describe in detail the manner in which the well was plugged, indicating where the mud fluid was placed and the method or methods used in introducing it into the hole. If cement or other plugs were used, state the character of same and depth placed, from _____ feet to _____ feet for each plug set.

gun pits filled with heavy mud - set first plug at 202' poured 20 sacks of cement thru drill pipe - filled with heavy mud to 35', set second plug - filled to surface with cement

RECEIVED
STATE CORPORATION COMMISSION
MAY 24 - 1957
CONSERVATION DIVISION
Wichita, Kansas

(If additional description is necessary, use BACK of this sheet)
Name of Plugging Contractor Red Drilling Company
Address box 786, El Dorado, Kansas

STATE OF Kansas, COUNTY OF Butler, ss.
O N Wilson - contractor (employee of owner) or (owner or operator) of the above-described well, being first duly sworn on oath, says: That I have knowledge of the facts, statements, and matters herein contained and the log of the above-described well as filed and that the same are true and correct. So help me God.

(Signature) O. N. Wilson
O N Wilson El Dorado, Kansas
(Address)

SUBSCRIBED AND SWORN to before me this 3rd day of May, 19 57

My commission expires November 27, 1958 [Signature] Notary Public.

PLUGGING
FILE SEC. 7 T. 25 R. 23W
BOOK PAGE 70 LINE 25

WELL LOG

Operator: D E Dunne, Jr.
Comm 4-8-1957 Comp 4-29-1957
Shot _____ Qts. From _____ ft. To _____ ft.
Acidized _____ Gal. _____
Prod. Formation _____
Initial Prod. dry hole
Elevation _____

Lease Cobb Well No. 1
Loc NENE Sec 7 Twp 25 Rge 23W
County Ford State Kansas
Contractor Red Drilling Company
Casing Record
Size 8 5/8 Ft. 202 Pulled w/150 Sacks Remarks

FIGURES INDICATE BOTTOM OF FORMATION

40 surface
202 sandy shale
468 red rock-shale
650 shale & shells
725 sand
1685 red bed & shale
2220 shale & shells
2910 lime & shale
3077 Lime
3159 lime & shale
3340 shale
3805 shale & lime
3808 shale
4005 shale & lime
4100 lime
4175 shale & lime
4260 lime
4280 shale & lime
4520 lime
4555 lime & shale
4623 lime
4724 lime & shale
4794 lime
4801 lime

TD 4801'

RECEIVED
STATE CORPORATION COMMISSION
MAY 4 - 1957
CONSERVATION DIVISION
Wichita, Kansas

PLUGGING
FILE SEC 7 T 25 R 23W
BOOK PAGE 10 LINE 25