

WELL PLUGGING RECORD

Give All Information Completely
Make Required Affidavit
Mail or Deliver Report to:
Conservation Division
State Corporation Commission
211 No. Broadway
Wichita, Kansas

Ford County, Sec. 22 Twp. 25S Rge. 24W (E) (W)

Location as "NE/CNW/SW" or footage from lines C NE SW

Lease Owner Martin & Keller

Lease Name Leidigh Well No. 1

Office Address 1035 Kennedy Bldg., Tulsa, Okla.

Character of Well (completed as Oil, Gas or Dry Hole) Dry Hole

Date well completed 7-8-65 19

Application for plugging filed 7-8-65 19

Application for plugging approved 7-8-65 19


Plugging commenced 7-8-65 19

Plugging completed 7-8-65 19

Reason for abandonment of well or producing formation Dry Hole

If a producing well is abandoned, date of last production 19

Was permission obtained from the Conservation Division or its agents before plugging was commenced? yes

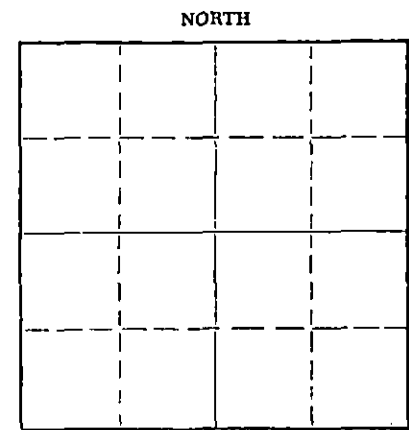

Name of Conservation Agent who supervised plugging of this well Archie Elving for Hugh Scott, Sublette, Ks.

Producing formation _____ Depth to top _____ Bottom _____ Total Depth of Well 5319 Feet

Show depth and thickness of all water, oil and gas formations.

OIL, GAS OR WATER RECORDS

CASING RECORD

FORMATION	CONTENT	FROM	TO	SIZE	PUT IN	PULLED OUT
				8 5/8"	345'	none

Describe in detail the manner in which the well was plugged, indicating where the mud fluid was placed and the method or methods used in introducing it into the hole. If cement or other plugs were used, state the character of same and depth placed, from _____ feet to _____ feet for each plug set.

Pushed plug to 700', put 25 sks. cement through drill pipe
Filled hole with mud to 300', set plug, 1/4 sk. hulls 25 sks. cement
Filled hole with mud to 40', set plug, 3/8 sk. hulls 10 sks. cement
added 5 sks. in rathole

RECEIVED
STATE CORPORATION COMMISSION
7-13-65
JUL 13 1965

CONSERVATION DIVISION
Wichita, Kansas

(If additional description is necessary, use BACK of this sheet)

Name of Plugging Contractor Leben Drilling, Inc.

Address Box 486, Great Bend, Kansas

STATE OF KANSAS, COUNTY OF BARTON, ss.

Leslie Kite (employee of owner) or (owner or operator) of the above-described well, being first duly sworn on oath, says: That I have knowledge of the facts, statements, and matters herein contained and the log of the above-described well as filed and that the same are true and correct. So help me God.

(Signature) Leslie Kite

P. O. Box 486, Great Bend, Kansas (Address)

SUBSCRIBED AND SWORN TO before me this 12th day of July, 1965

My commission expires April 1, 1967

Glenda S. [Signature] Notary Public.

DRILLER'S LOG

COMPANY: Martin & Keller
 CONTRACTOR: LEBEN DRILLING, INC.
 FARM: LEIDIGH #1
 LOCATION: C NE SW Sec. 22-25S-24W
 FORD COUNTY, KANSAS
 COMMENCED: 6-24-65
 COMPLETED: 7-8-65

0	45	Sand & Rock
45	210	Sand & Shale
210	370	Blue Shale
370	1440	Shale & Sand
1440	2270	Shale
2270	2615	Shale & Lime
2615	2975	Lime & Shale
2975	3118	Shale & Lime
3118	4215	Shale & Lime (Chalky)
4215	4460	Lime
4460	4605	Lime (Chalky)
4605	5319	Lime
	<u>5319</u>	<u>RTD - D. & A.</u>

RECEIVED
 STATE CORPORATION COMMISSION
 JUL 13 1965
 CONSERVATION DIVISION
 Wichita, Kansas

Set 8 5/8" used surface casing @ 345' with 200 sacks 60-40 Posmix
 Sunset 2% Gel

I, Leslie Kite, do hereby certify that the above and foregoing is
 a true and correct copy of the log of the Leidigh #1 well, located
 C NE SW of Section 22, Township 25 South, Range 24 West, Ford County,
 Kansas, as reflected by the records of Leben Drilling, Inc.

Leslie Kite

Leslie Kite

STATE OF KANSAS)
) SS
 COUNTY OF BARTON)

Subscribed and sworn to before me, a Notary Public, in and
 for Barton County, Kansas, this 12th day of July, 1965.

Ulanda Nichols

Ulanda Nichols

My Commission Expires
 April 1, 1967