


WELL PLUGGING RECORD

Give All Information Completely  
Make Required Affidavit  
Mail or Deliver Report to:  
Conservation Division  
State Corporation Commission  
211 No. Broadway  
Wichita, Kansas

Gray County, Sec. 6 Twp. 25S Rge. 28W (E) (W)  
Location as "NE/CNW/SW" or footage from lines NW NW  
Lease Owner Patrick Petroleum Corporation  
Lease Name Snowbarger Well No. 1  
Office Address Suite 400 - 120 Bldg. -120 S. Market-Wichita, Ks. 67202  
Character of Well (completed as Oil, Gas or Dry Hole) Dry hole  
Date well completed 11/1/77 19  
Application for plugging filed 11/1/77 19  
Application for plugging approved 11/1/77 19  
Plugging commenced 11/1/77 19  
Plugging completed 11/1/77 19  
Reason for abandonment of well or producing formation Dry Hole  
If a producing well is abandoned, date of last production 19  
Was permission obtained from the Conservation Division or its agents before plugging was commenced? Yes

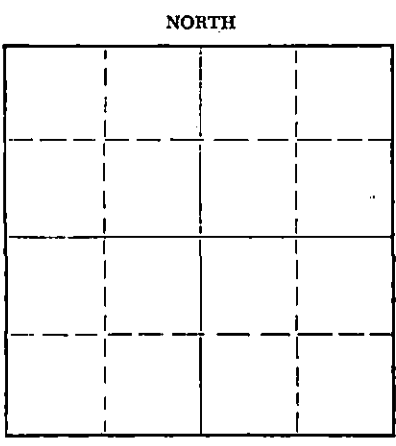

Locate well correctly on above Section Plat

Name of Conservation Agent who supervised plugging of this well Leo Massey  
Producing formation \_\_\_\_\_ Depth to top \_\_\_\_\_ Bottom \_\_\_\_\_ Total Depth of Well 5090 Feet  
Show depth and thickness of all water, oil and gas formations.

OIL, GAS OR WATER RECORDS

CASING RECORD

FORMATION	CONTENT	FROM	TO	SIZE	PUT IN	PULLED OUT
	Surface			8 5/8"	471'	0

Describe in detail the manner in which the well was plugged, indicating where the mud fluid was placed and the method or methods used in introducing it into the hole. If cement or other plugs were used, state the character of same and depth placed, from \_\_\_\_\_ feet to \_\_\_\_\_ feet for each plug set.

1st Plug @ 470' w/40 sx  
2nd Plug @ 40' w/10 sx  
Rat Hole w/5 sx

RECEIVED  
STATE CORPORATION COMMISSION  
11-7-77  
NOV 07 1977  
CONSERVATION DIVISION  
Wichita, Kansas

Name of Plugging Contractor Thunderbird Drilling, Inc.  
Address P. O. Box 18407- Wichita, Kansas 67218

STATE OF KANSAS, COUNTY OF SEDGWICK, ss.  
Burke Krueger (employee of owner) or (owner or operator) of the above-described well, being first duly sworn on oath, says: That I have knowledge of the facts, statements, and matters herein contained and the log of the above-described well as filed and that the same are true and correct. So help me God.

(Signature) *Burke Krueger*  
P. O. Box 18407- Wichita, Ks. 67218 (Address)

SUBSCRIBED AND SWORN TO before me this 4th day of November, 19 77

My commission expires 3-25-80  
Gloria DeJesus Notary Public.



