

STATE OF KANSAS
STATE CORPORATION COMMISSION
200 Colorado Derby Building
Wichita, Kansas 67202

WELL PLUGGING RECORD
K.A.R.-82-3-117

API NUMBER 15-055-00579-0000

LEASE NAME MURPHY GU

WELL NUMBER 1

2490 Ft. from S Section Line

2790 Ft. from E Section Line

SEC. 25 TWP 25S RGE. 33 (E) or (W)

COUNTY FINNEY

Date Well Completed 9/52

Plugging Commenced 5/18/94

Plugging Completed 5/18/94

LEASE OPERATOR AMOCO PRODUCTION COMPANY

ADDRESS P O BOX 800, ROOM 925, DENVER, CO 80201

PHONE# (303) 830-5130 OPERATORS LICENSE NO. 5952

Character of Well GAS

(Oil, Gas, D&A, SWD, Input, Water Supply Well)

The plugging proposal was approved on _____ (date)

by STEVE DURRANT (KCC District Agent's Name).

Is ACO-1 filed? YES If not, is well log attached? _____

Producing Formation CHASE Depth to Top 2566 Bottom 2726 T.O. 2726

Show depth and thickness of all water, oil and gas formations.

OIL, GAS OR WATER RECORDS

CASING RECORD

Formation	Content	From	To	Size	Put In	Pulled out
SURFACE				8 5/8"	500	

Describe in detail the manner in which the well was plugged, indicating where the mud fluid was placed and the method or methods used in introducing it into the hole. If cement or other plugs were used, state the character of same and depth placed, from ___ feet to ___ feet each set.
copy attached

(If additional description is necessary, use BACK of this form.)

Name of Plugging Contractor HALLIBURTON License No. _____

Address _____

NAME OF PARTY RESPONSIBLE FOR PLUGGING FEES: AMOCO PRODUCTION COMPANY

STATE OF COLORADO COUNTY OF DENVER, ss.

(Employee of Operator) or (Operator) of above-described well, being first duly sworn on oath, says: That I have knowledge of the facts, state of mind and matters herein contained and the log of the above-described well as filed that they are true and correct, so help me God.

(Signature) Joe Enders

(Address) _____

SUBSCRIBED AND SWORN TO before me this 14th day of October 1994

Joe Enders
Notary Public



My Commission Expires 6/2/1998

Mid-Continent PBU Completion

File: DWB- -400.1

Operating Center Foreman: Kelly Gindlesberger Date: 4/12/94

Type of Operation: Plug and Abandonment

Lease and Well Name: Murphy GU No. 1

Field: Hugoton

Formation: Chase

Location: Sec 25, T-25-S, R-33-W, Finney County, Kansas

Elevation: 2921' Ref Pt: KB

TD: 2726' PBD: 2726'

Surface Csg: 8.625", 24# CSA: 500'


Production Csg: 5.5", 17# CSA: 2572'

Liner: 4.5", 15.5# at 2566'-2726'

Purpose: To PxA subject well.

WELLBORE SKETCH

PROCEDURE

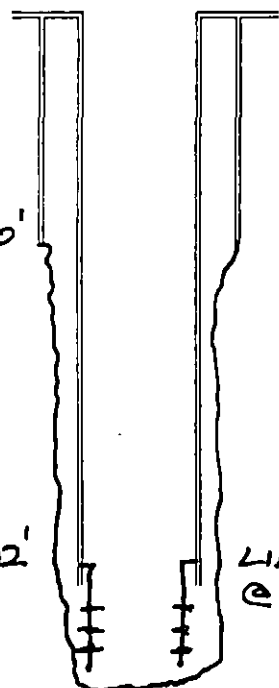

1. TOH with tbg, rods, and pump.
2. Set CIBP with 2 sx of cement at 2500'.
3. Circulate hole with 9 ppg mud (36 visc.)
4. Set cement plug from 550' to 5'.
5. Cut off casing 5' below ground and weld on steel cap with lease identification.
6. Restore location.

Prepared By: Ed Long

Approved By:

Distribution:

- * Ellen Hartzler - Rm. 925
- K. Gindlesberger - Ulysses
- B. Y. Roundtree - Rm. 927
- R. Jenisch - Ulysses
- J. Doerschlag - Ulysses

STATE CORPORATION COMMISSION

* Original to Ellen Hartzler who will send to wellfiles.

OCT 21 1994

CONSERVATION DIVISION
WICHITA, KANSAS

5 1/2" @ 2572'

LINER (SLOT/PERF)
@ 2566'-2726'

TD = 2726' PBD = 2726'