


STATE OF KANSAS
STATE CORPORATION COMMISSION

15-015-22245-00-00
WELL PLUGGING RECORD

Give All Information Completely
Make Required Affidavit
Mail or Deliver Report to
Conservation Division
State Corporation Comm.
245 North Water
Wichita, KS 67202

Butler County. Sec. 32 Twp. 26S Rge. 8 E
Location as "NE/CNW $\frac{1}{4}$ SW $\frac{1}{4}$ " or footage from lines
2640' FEL 2310' FSL SE/4
Lease Owner Range Oil Company, Inc.
Lease Name Drumm Institute Well No. 1
Office Address 240 Page Court, 220 W. Douglas, Wichita, Kansas
Character of Well (Completed as Oil, Gas or Dry Hole)

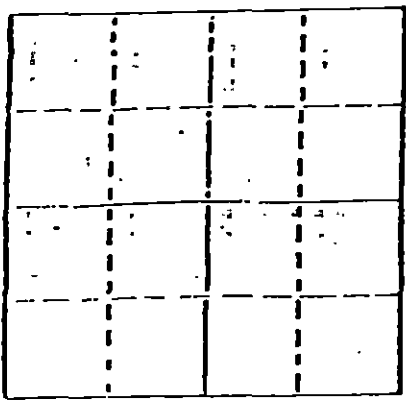

Locate well correctly on above
Section Plat

Dry Hole
Date Well completed 5-11 1983
Application for plugging filed 5-11 1983
Application for plugging approved 5-11 1983
Plugging commenced 5-11 1983
Plugging completed 5-11 1983
Reason for abandonment of well or producing formation

Dry Hole
If a producing well is abandoned, date of last production 19

Was permission obtained from the Conservation Division or its agents before plugging was commenced? Yes

Name of Conservation Agent who supervised plugging of this well Don Thompson
Producing formation Depth to top Bottom Total Depth of Well 2862
Show depth and thickness of all water, oil and gas formations.

OIL, GAS OR WATER RECORDS

CASING RECORD

FORMATION	CONTENT	FROM	TO	SIZE	PUT IN	PULLED OUT
				8-5/8	218	0

Describe in detail the manner in which the well was plugged, indicating where the mud fluid was placed and the method or methods used in introducing it into the hole. If cement or other plugs were used, state the character of same and depth placed, from feet to feet for each plug set.

Mud to surface
Spotted 35 sx cement @ 270'
Spotted 25 sx cement @ 60'
Spotted 10 sx cement in rat hole
United Cementing Ticket #3084

(If additional description is necessary, use BACK of this sheet)

Name of Plugging Contractor Range Drilling Company, Inc.

STATE OF Kansas COUNTY OF Sedgwick, ss.


Gary L. Reed (employee of owner) or (owner or operator)

of the above-described well, being first duly sworn on oath, says: That I have knowledge of the facts, statements, and matters herein contained and the log of the above-described well is filed and that the same are true and correct. So help me God.

(Signature) Gary L. Reed
240 Page Court, 220 W. Douglas, Wichita, Kansas
(Address)

SUBSCRIBED AND SWORN TO before me this 20th day of May, 1983

Nora S. Davidson
Notary Public.

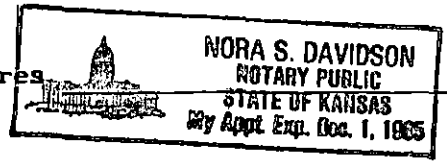

RECEIVED
STATE CORPORATION COMMISSION

MAY 23 1983

CONSERVATION DIVISION
Wichita, Kansas