

15.151-19014-00.00


STATE OF KANSAS  
STATE CORPORATION COMMISSION

Form CP-4

WELL PLUGGING RECORD

Give All Information Completely  
Make Required Affidavit  
Mail or Deliver Report to:  
Conservation Division  
State Corporation Commission  
212 No. Market  
Wichita, Kansas

NORTH

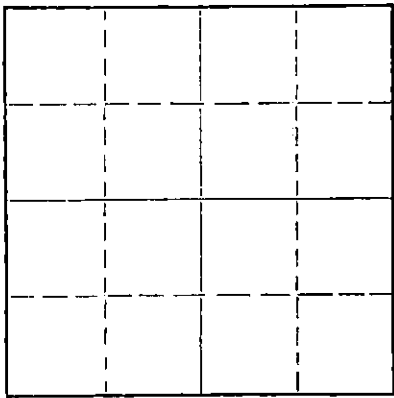

Locate well correctly on above  
Section Plat

PRATT County. Sec. 23 Twp. 29S Rge. 14 (E) 14 (W)

Location as "NE/CNW/SW" or footage from lines C NE SW NE

Lease Owner NADEL & GUSSMAN

Lease Name MOSS Well No. 2

Office Address 1714 FIRST NATIONAL BLDG - TULSA, OKLAHOMA

Character of Well (completed as Oil, Gas or Dry Hole) OIL

Date well completed 19\_\_

Application for plugging filed February 15 19 68

Application for plugging approved 19\_\_

Plugging commenced FEBRUARY 20 19 68

Plugging completed FEBRUARY 27 19 68

Reason for abandonment of well or producing formation DEPLETED

If a producing well is abandoned, date of last production 19\_\_

Was permission obtained from the Conservation Division or its agents before plugging was commenced? YES

Name of Conservation Agent who supervised plugging of this well ARCHIE ELVING

Producing formation Depth to top Bottom Total Depth of Well 4635 Feet

Show depth and thickness of all water, oil and gas formations.

OIL, GAS OR WATER RECORDS

CASING RECORD

FORMATION	CONTENT	FROM	TO	SIZE	PUT IN	PULLED OUT
				8 5/8"	776'	NONE
				5 1/2"	4633'	3843.12'

Describe in detail the manner in which the well was plugged, indicating where the mud fluid was placed and the method or methods used in introducing it into the hole. If cement or other plugs were used, state the character of same and depth placed, from feet to feet for each plug set.

4635'	-	4521'	-	PLUG
4521'	-	4475'	-	SAND
4475'	-	4435'	-	5 SACKS CEMENT
4435'	-	400'	-	MUD
400'	-	390'	-	ROCK BRIDGE
390'	-	315'	-	25 SACKS CEMENT
315'	-	40'	-	MUD
40'	-	30'	-	ROCK BRIDGE
30'	-	BASE	-	10 SACKS CEMENT

RECEIVED  
STATE CORPORATION COMMISSION  
MAR 1 1 1968  
CONSERVATION DIVISION  
Wichita, Kansas

(If additional description is necessary, use BACK of this sheet)

Name of Plugging Contractor SANTA-FE PIPE & SUPPLY, INC.  
Address P. O. BOX 562 - GREAT BEND, KANSAS

STATE OF KANSAS COUNTY OF BARTON, ss.  
T. L. NUTT (employee of owner) or (owner) of the above-described well, being first duly sworn on oath, says: That I have knowledge of the facts, statements, and matters herein contained and the log of the above-described well as filed and that the same are true and correct. So help me God.

(Signature) [Signature]  
BOX 562 - GREAT BEND, KANSAS  
(Address)

SUBSCRIBED AND SWORN TO before me this 9th day of March, 19 68

My commission expires July 31, 1970  
Mary M. Guesner Notary Public.

WELL LOG BUREAU—KANSAS GEOLOGICAL SOCIETY  
508 East Murdock, Wichita, Kansas


COPY

Company- NADEL & GUSSMAN  
Farm- Moss No.2

SEC. 23 T. 29 R. 14W  
NE SW NE

Total Depth. 4635'  
Comm. 4-18-62 Comp. 5-3-62  
Shot or Treated.  
Contractor. K & E Drilling, Inc.  
Issued. 9-22-62

County Pratt  
KANSAS

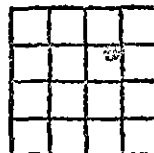

Elevation. 1945' DF

Production. TEMP ABDN

CASING:

8 5/8" 775' cem w/460 sx.  
5 1/2" 4633' cem w/125 sx.

Figures Indicate Bottom of Formations.

sand & gravel	190
red bed	768
anhydrite	776
shale	2000
shale & lime	2190
lime	2311
lime & shale	2585
lime	2846
lime & shale	3060
lime	3220
lime & shale	3350
lime	3591
lime & shale	3700
lime	4520
limy chert & sand	4530
lime	4534
sand	4546
sand & lime	4555
sand, lime & pyrite	4569
shale & lime	4609
dolomite-arbuckle	4635'
Total Depth	

TOPS: SAMPLE

Heebner	3765
Toronto	3783
Douglas	3800
Lansing	3961
Brown Lime	3944
Marmaton	4360
Simpson Sand	4516
Arbuckle	4620

RECEIVED  
STATE CORPORATION COMMISSION  
FEB 21 1968  
CONSERVATION DIVISION  
Wichita, Kansas