


STATE OF KANSAS  
STATE CORPORATION COMMISSION

Give All Information Completely  
Make Required Affidavit  
Mail or Deliver Report to:  
Conservation Division  
State Corporation Commission  
212 No. Market  
Wichita, Kansas

WELL PLUGGING RECORD

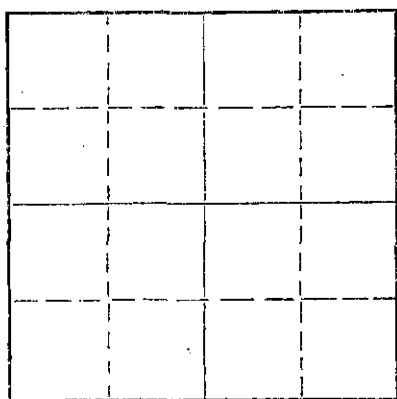

Locate well correctly on above  
Section Plat

PRATT County, Sec. 23 Twp. 29S Rge. (E) 14W (W)  
Location as "NE/CNW/SE/SW" or footage from lines. NE NW NE  
Lease Owner NADEL & GUSSMAN  
Lease Name MOSS Well No. 3  
Office Address 625 UNION CENTER - WICHITA, KANSAS  
Character of Well (completed as Oil, Gas or Dry Hole) OIL  
Date well completed JUNE 12 19 62  
Application for plugging filed SEPTEMBER 11 19 69  
Application for plugging approved 19  
Plugging commenced SEPTEMBER 12 19 69  
Plugging completed SEPTEMBER 17 19 69  
Reason for abandonment of well or producing formation DEPLETED

If a producing well is abandoned, date of last production 19  
Was permission obtained from the Conservation Division or its agents before plugging was commenced? YES

Name of Conservation Agent who supervised plugging of this well MR. WARREN  
Producing formation \_\_\_\_\_ Depth to top \_\_\_\_\_ Bottom \_\_\_\_\_ Total Depth of Well 4536' Feet  
Show depth and thickness of all water, oil and gas formations.

OIL, GAS OR WATER RECORDS

CASING RECORD

FORMATION	CONTENT	FROM	TO	SIZE	PUT IN	PULLED OUT
				8 5/8"	810'	NONE
				5 1/2"	4532'	3789.12'

Describe in detail the manner in which the well was plugged, indicating where the mud fluid was placed and the method or methods used in introducing it into the hole. If cement or other plugs were used, state the character of same and depth placed, from \_\_\_\_\_ feet to \_\_\_\_\_ feet for each plug set.

4536' - 4520' - SAND  
 4520' - 4480' - 5 SACKS CEMENT  
 4480' - 400' - MUD  
 400' - 390' - ROCK BRIDGE  
 390' - 315' - 25 SACKS CEMENT  
 315' - 40' - MUD  
 40' - 30' - ROCK BRIDGE  
 30' - BASE - 10 SACKS CEMENT

RECEIVED  
STATE CORPORATION COMMISSION  
OCT 15 1969  
CONSERVATION DIVISION  
Wichita, Kansas

10-15-69

(If additional description is necessary, use BACK of this sheet)

Name of Plugging Contractor SANTA-FE PIPE & SUPPLY, INC.  
Address BOX 562 - GREAT BEND, KANSAS

STATE OF KANSAS COUNTY OF BARTON ss.  
T. L. Nutt (employee of owner) or (owner) of the above-described

well, being first duly sworn on oath, says: That I have knowledge of the facts, statements, and matters herein contained and the log of the above-described well as filed and that the same are true and correct. So help me God.

(Signature) *T. L. Nutt*

BOX 562 - GREAT BEND, KANSAS (Address)

SUBSCRIBED AND SWORN TO before me this 11th day of October, 19 69

*Mary M. Guesnier*  
Mary M. Guesnier Notary Public.

commission expires July 31, 1970

WELL LOG BUREAU—KANSAS GEOLOGICAL SOCIETY  
508 East Murdock, Wichita, Kansas

COPY


Company- NADEL & GUSSMAN  
Farm- Moss No. 3

SEC. 23 T. 29 R. 14W  
NE NW NE

Total Depth. 4536'  
Comm. 5-31-62 Comp. 6-12-62

County Pratt KANSAS

Shot or Treated.  
Contractor. K & E Drilling, Inc.  
Issued. 10-27-62

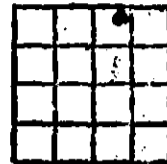

CASING:  
8 5/8" 810' cem w/500 sx.  
5 1/2" 4532' cem w/100 sx.

Elevation. 1953' DF

Production. 157 BOPD, NW

Figures Indicate Bottom of Formations.

sand	200
red bed	575
red bed & sand streaks	620
red bed	780
shale & shells	814
red bed	875
shale & sand streaks	1000
shale & red bed	1745
shale & shells	2085
shale & lime	2701
lime	2845
shale & lime	3189
lime	4536 RTD
Total Depth	

TOPS: SAMPLE	
Heebner	3762
Lansing	3971
Base Kansas City	4354
Viola	4450
Simpson Shale	4512
Simpson Sand	4514
Toronto	3780
Brown Lime	3955

RECEIVED  
STATE CORPORATION COMMISSION  
SEP 12 1969  
CONSERVATION DIVISION  
Wichita, Kansas