

STATE OF KANSAS
STATE CORPORATION COMMISSION

WELL PLUGGING RECORD
OR
FORMATION PLUGGING RECORD

Strike out upper line when reporting plugging off formations.

Rec'd 10-6-36

Give All Information Completely
Make Required Affidavit
Mail or Deliver Report to:
Conservation Division
State Corporation Commission,
800 Bittling Building,
Wichita, Kansas

RENO County. Sec. 25 Twp. 24S Rge (E) 5 (W)

Location as "NE 1/4 NW 1/4 SW 1/4" or footage from lines S 1/2 SW 1/4 NE 1/4

Lease Owner The Aylward Production Company

Lease Name Mueller Well No. 1

Office Address 708 Ellis-Singleton Building - Wichita, Kansas.

Character of Well (Completed as Oil, Gas or Dry Hole) DRY

Date, well completed. October 1, 1936

Application for plugging filed. October 5, 1936

Application for plugging approved. 1936


Plugging Commenced. October 2, 1936

Plugging Completed. October 5, 1936

Reason for abandonment of well or producing formation Dry

If a producing well is abandoned, date of last production 1936

Was permission obtained from the Conservation Division or its agents before plugging was commenced? Yes

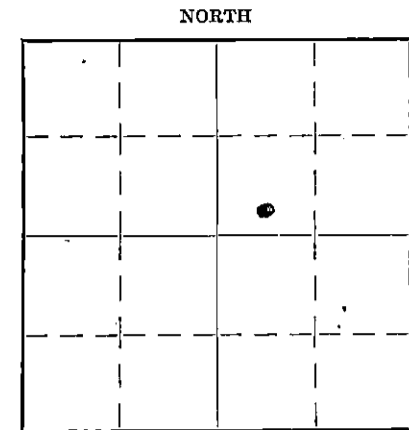

Locate well correctly on above Section Plat

Name of Conservation Agent who supervised plugging of this well

Producing formation Depth to top Bottom Total Depth of Well 3827 Feet

Show depth and thickness of all water, oil and gas formations.


OIL, GAS OR WATER RECORDS

CASING RECORD

Formation	Content	From	To	Size	Put In	Pulled Out
				12 1/2"	241'	
				6 5/8"	3368'	2905'
				5 3/16"	3730	3730'

Describe in detail the manner in which the well was plugged, indicating where the mud fluid was placed and the method or methods used in introducing it into the hole. If cement or other plugs were used, state the character of same and depth placed, from feet to feet for each plug set.

Filled with mud from 3827' to 3600'; set bridge at 295' and 20' cement plug set. Filled with mud to 10' of top, then filled with cement and rock to top, with cement cap on top.

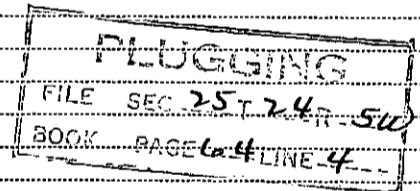

(If additional description is necessary use BACK of this sheet)

Correspondence regarding this well should be addressed to The Aylward Production Company, 708 Ellis-Singleton Building, Wichita, Kansas.

STATE OF KANSAS, COUNTY OF SEDGWICK, ss.

J. R. Sims (employee of owner) or (owner or operator) of the above-described well, being first duly sworn on oath, says: That I have knowledge of the facts, statements, and matters herein contained and the log of the above-described well as filed and that the same are true and correct. So help me God.

(Signature) J. R. Sims
510 S. Broadview - Wichita KS
(Address)

SUBSCRIBED AND SWORN to before me this 6th day of October, 1936

My commission expires January 19, 1939.

Alfred J. Shalby Notary Public.

MUELLER WELL NO. 1

Company - The Aylward Production Company
 Contractor - The Aylward Production Company

Location: S¹/₂SW¹/₄ of
 Section 25-243-5W,
 Reno County, Kansas.

Commenced - August 21, 1936.
 Completed - October 1, 1936.

Elevation: 1489'

<u>Formation</u>	<u>From</u>	<u>To</u>	<u>Remarks</u>
Surface clay	0	32	
water sand	32	42	
sand	42	171	
sand & lime shells	171	205	
shale & shells	205	236	
shale	236	241	Set 12 ¹ / ₂ " at 241' w/100 sx Lone Star
shale & shells	241	440	and 100 sx Encore Cement.
shale	440	470	
lime	470	474	
shale salt	474	650	
salt shale break	650	737	
shale & shells	737	819	
shale shells	819	859	
shale lime shells	859	880	
sandy shale	880	914	
lime shale breaks	914	925	
lime	925	935	
shale & shells	935	990	
shale & sand	990	1010	
lime broken	1010	1050	
shale shells	1050	1108	
lime shale	1108	1157	
lime broken & shale	1157	1247	
lime & shale	1247	1391	
shale	1391	1450	
lime broken	1450	1470	
shale	1470	1516	
shale shells	1516	1658	
shale lime	1658	1770	
shale & lime shells	1770	1855	
shale shells	1855	1870	
lime broken	1870	1880	
shale shells	1880	1955	
lime	1955	1970	
shale	1970	1990	
lime	1990	2005	
shale	2005	2074	
lime	2074	2097	
shale	2097	2114	
shale lime	2114	2225	
sand	2225	2240	
lime	2240	2250	
shale lime	2250	2290	
shale & shells	2290	2370	
shale	2370	2395	
lime sandy	2395	2420	
shale & shells	2420	2440	
shale & lime shells	2440	2535	
shale	2535	2540	
lime broken	2540	2560	
shale	2560	2620	
lime broken	2620	2640	
lime	2640	2675	
lime broken	2675	2683	
lime	2683	2758	
lime hard	2758	2800	
lime	2800	2805	
shale & lime shells	2805	2826	
lime	2826	2867	
lime broken	2867	2890	
lime hard	2890	2906	
shale	2906	2916	
lime broken	2916	2925	
shale shells	2925	2961	
lime hard	2961	2991	
lime	2991	3050	

MUELLER WELL NO. 1

<u>Formation</u>	<u>From</u>	<u>To</u>	<u>Remarks</u>
Lime broken	3050	3084	
lime	3084	3101	
shale & lime shells	3101	3129	
lime broken	3129	3208	
shale shells	3208	3225	
lime broken	3225	3254	
shale	3254	3286	
lime broken	3286	3295	
shale	3295	3350	
shale lime	3350	3365	
Chat	3365	3595	Set 7" OD @ 3369', cemented w/50 sacks.
lime	3395	3520	1 1/2" B.W. at 3378-3388' - H.F.W. 3405-15'
lime sandy	3520	3550	
lime	3550	3572	
slate	3572	3595	
slate blue	3595	3600	
slate	3600	3610	
slate blue	3610	3615	
shale light	3615	3635	
slate	3635	3655	
slate gray	3655	3702	Set 5 3/16" Casing at 3655'.
lime sandy	3702	3713	H.F.W. at 3702-4'; small show oil 3703-4'
shale	3713	3718	
slate	3718	3730	
lime	3730	3734	5 5/16" U.R. to 3730'
shale	3734	3748	
lime	3748	3750	
shale sandy	3750	3770	
slate sandy	3770	3797	
lime	3797	3814	
sand	3814	3827	T.D. H.F.W. at 3827'