

15-155-01995-0000

STATE OF KANSAS  
STATE CORPORATION COMMISSION

WELL PLUGGING RECORD

OR  
FORMATION PLUGGING RECORD


Strike out upper line  
when reporting plug-  
ging of formations.

Give All Information Completely  
Make Required Affidavit  
Mail or Deliver Report to:  
Conservation Division  
State Corporation Commission  
800 Bittling Building  
Wichita, Kansas

Reno County. Sec. 24 Twp. 24 Rge. 5 (X) (W)

Location as "NE<sup>1</sup>/<sub>4</sub>NW<sup>1</sup>/<sub>4</sub>SW<sup>1</sup>/<sub>4</sub>" or footage from lines. CS<sup>1</sup>/<sub>2</sub> SE SE  
Lease Owner. Raymond Gear et al  
Lease Name. Petersheim Well No. 1  
Office Address. 607 Wolcott Bldg., Hutchinson, Kansas  
Character of Well (completed as Oil, Gas or Dry Hole). dry  
Date well completed. June 18, 1945  
Application for plugging filed. July 23, 1945  
Application for plugging approved. July 23, 1945  
Plugging commenced. July 24, 1945  
Plugging completed. July 29, 1945  
Reason for abandonment of well or producing formation. dry hole

NORTH

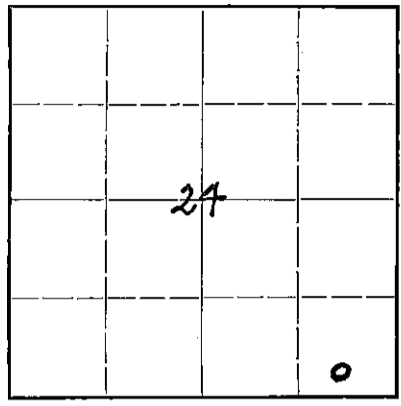

Locate well correctly on above  
Section Plat

If a producing well is abandoned, date of last production. 19...  
Was permission obtained from the Conservation Division or its agents before plugging was com-  
menced? yes.

Name of Conservation Agent who supervised plugging of this well. Durkee  
Producing formation. Depth to top. Bottom. Total Depth of Well 3398 Feet  
Show depth and thickness of all water, oil and gas formations.

OIL, GAS OR WATER RECORDS

CASING RECORD

Formation	Content	From	To	Size	Put In	Pulled Out
				8 5/8"	615'	none
				5 1/2"	3347'	1814'

Describe in detail the manner in which the well was plugged, indicating where the mud fluid was placed and the method or methods used in introducing it into the hold. If cement or other plugs were used, state the character of same and depth placed, from...feet to...feet for each plug set.

6 sacks 3345 15 sacks at 300 5 sacks at top  
Run 6 sacks cement at 3345.  
Set bridge at 300 run 15 sacks cement. Mudded to top. Capped  
with 5 sacks cement.

PLUGGING  
FILE No. 24 24 25 W  
BOOK PAGE 21 LINE 16



8-10-45

(If additional description is necessary, use BACK of this sheet)

Correspondence regarding this well should be addressed to. Raymond Gear  
Address. Box 81, Hutchinson, Kansas

STATE OF Kansas, COUNTY OF Reno, ss.  
Raymond Gear (employee of owner) or (owner or operator) of the above-described well,

being first duly sworn on oath, says: That I have knowledge of the facts, statements, and matters herein contained and the log of the above-described well as filed and that the same are true and correct. So help me God.

(Signature) Raymond Gear

Box 81, Hutchinson, Kansas (Address)

SUBSCRIBED AND SWORN to before me this 9th day of August, 19 45

Eleanor J. Warren Notary Public.

My commission expires March 10, 1948

COMPANY: Raymond Gear et al  
 CONTRACTOR: Premier Drilling Co.  
 FARM: Petersheim #1  
 LOCATION: CS $\frac{1}{2}$  SE SE, Reno County  
 Section 24-24-5W  
 COMMENCED: May 7, 1945  
 COMPLETED: Rotary - June 1, 1945

0	to	550		Surface shale & shells
550	to	605		Shale & shells
605	to	615		Lime
615	to	650		Shale and Lime shells
650	to	680		Broken lime & shale
680	to	750		Lime
750	to	832		Shale & shells
832	to	1169		Lime
1169	to	1890		Lime & shale
1890	to	1945		Shale
1945	to	1975		Broken lime
1975	to	1990		Shale
1990	to	2308		Lime & shale
2308	to	2495		Lime
2495	to	2517		Shale & broken lime
2517	to	2653		Shale & lime
2653	to	3172		Lime
3172	to	3210		Lime & shale
3210	equals	3200	S.L.M. Correction	
3200	to	3221		Lime & shale
3221	to	3286		Shale
3286	to	3337		Shale & lime shells
3337	to	3343		Shale & shells
3343	to	3375		Chat
		3375		T.D. - Rotary
3375	to	3385		Chat--no saturation C.T.H.
3385	to	3395		Cherty - light stain
3395	to	3398		Chert D & A

Swabbed 1 1/4 bbls. oil and 2 1/2 bbls. water per hour

Set 615 feet of 8 5/8" surface pipe.  
 5 1/2" casing set at 3347.

8-10-45

C E R T I F I C A T E

I, Raymond Gear, do hereby certify that the above and foregoing is a true and correct copy of the log of the Petersheim #1, Section 24-24-5W, Reno County, as reflected by my files.

*Raymond Gear*

Subscribed and sworn to before me a Notary Public within and for Reno County, Kansas, this 9th day of August 1945.

My commission expires:  
 March 10, 1948

*Eleanor J. Garrison*  
 Notary Public

