

WELL PLUGGING RECORD

STATE OF KANSAS STATE CORPORATION COMMISSION


Give All Information Completely Make Required Affidavit Mail or Deliver Report to: Conservation Division State Corporation Commission 800 Bittling Building Wichita, Kansas

FORMATION PLUGGING RECORD

Strike out upper line when reporting plugging off formations.

Reno County, Sec. 21 Twp. 24 Rge. (E) 4 (W) Location as "NE 1/4 NW 1/4 SW 1/4" or footage from lines NW 1/4 NW 1/4 NW 1/4 Lease Owner Solar Oil Corporation Lease Name W.J. Van Sickle Well No. One Office Address 1117 Union National Bank Bldg., Wichita, Kansas Character of Well (completed as Oil, Gas or Dry Hole) Oil Date well completed May 28 19 37 Application for plugging filed November 11 19 43 Application for plugging approved November 19 19 43 Plugging commenced November 15 19 43 Plugging completed November 23 19 43 Reason for abandonment of well or producing formation Water encroachment

NORTH

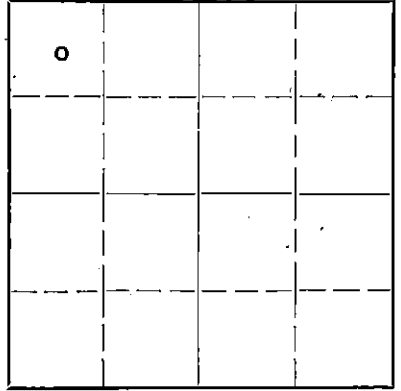

Locate well correctly on above Section Plat

If a producing well is abandoned, date of last production September 4 19 43 Was permission obtained from the Conservation Division or its agents before plugging was commenced? Yes

Name of Conservation Agent who supervised plugging of this well Ruel Dirke Producing formation Chat Depth to top 3333' Bottom 3359' Total Depth of Well 3359 Feet Show depth and thickness of all water, oil and gas formations.

OIL, GAS OR WATER RECORDS CASING RECORD

Table with 7 columns: Formation, Content, From, To, Size, Put In, Pulled Out. Row 1: Chat, Oil, 3333', 3359', 7" O.D., 3335', 3202'10". Row 2: (blank), (blank), (blank), (blank), 12 1/2" 54#, 500', none.

Describe in detail the manner in which the well was plugged, indicating where the mud fluid was placed and the method or methods used in introducing it into the hold. If cement or other plugs were used, state the character of same and depth placed, from feet to feet for each plug set.

Hole filled with gravel to 3335' and cemented with six sacks of cement at 3335' Filled with mud to 300' and cemented with twenty sacks of cement at 300' Filled with mud to base of cellar and cemented with eight sacks of cement at top of surface pipe.

PLUGGING FILE NO. 21 24 4 W BOOK PAGE 98 LINE 20

NOV 27 11-27-43

(If additional description is necessary, use BACK of this sheet)

Correspondence regarding this well should be addressed to Solar Oil Corporation Address 1117 Union National Bank Bldg., Wichita, Kansas

STATE OF KANSAS, COUNTY OF SEDGWICK, ss. R.E. Evans (employee of owner) or (owner or operator) of the above-described well, being first duly sworn on oath, says: That I have knowledge of the facts, statements, and matters herein contained and the log of the above-described well as filed and that the same are true and correct. So help me God.

(Signature) [Handwritten Signature]

Wichita, Kansas (Address)

SUBSCRIBED AND SWORN TO before me this 24th day of November, 1943.

[Handwritten Signature] Notary Public.

My commission expires October 31st, 1945.