


STATE OF KANSAS
STATE CORPORATION COMMISSION

WELL PLUGGING RECORD

Give All Information Completely
Make Required Affidavit
Mail or Deliver Report to:
Conservation Division
State Corporation Commission
800 Bitting Building
Wichita, Kansas

Reno County, Sec. 24 Twp. 24S Rge. 4 (E) W (W)
Location as "NE/CNW $\frac{1}{4}$ SW $\frac{1}{4}$ " or footage from lines NW NW SW
Lease Owner Buffalo Oil Company
Lease Name Morgan Well No. # 1
Office Address 1002 Petroleum Bldg, Tulsa, Oklahoma
Character of Well (completed as Oil, Gas or Dry Hole) Dry Hole
Date well completed May 28, 1950 19
Application for plugging filed May 26, 1950 Verbally 19
Application for plugging approved May 26, 1950 Verbally 19
Plugging commenced May 27, 1950 19
Plugging completed May 27, 1950 19
Reason for abandonment of well or producing formation Dry Hole

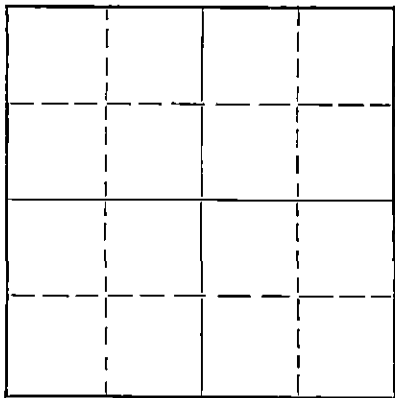

Locate well correctly on above Section Plat

If a producing well is abandoned, date of last production 19
Was permission obtained from the Conservation Division or its agents before plugging was commenced? Yes

Name of Conservation Agent who supervised plugging of this well Ruel Durkee
Producing formation _____ Depth to top _____ Bottom _____ Total Depth of Well 4027' Feet
Show depth and thickness of all water, oil and gas formations.

OIL, GAS OR WATER RECORDS

CASING RECORD

Formation	Content	From	To	Size	Put In	Pulled Out
				8 5/8"	466'	None

Describe in detail the manner in which the well was plugged, indicating where the mud fluid was placed and the method or methods used in introducing it into the hole. If cement or other plugs were used, state the character of same and depth placed, from _____ feet to _____ feet for each plug set.

Plugging Record

Plugged hole with bottom plug at 350'
and 20 sacks cement. Top plug at 25' and
5 sacks cement.

RECORDED

JUN 9 X 1950 6-9-50

STATE CORPORATION
COMMISSION
KANSAS

(If additional description is necessary, use BACK of this sheet)

Correspondence regarding this well should be addressed to Buffalo Oil Company
Address 1002 Petroleum Building, Tulsa, Oklahoma


STATE OF Kansas, COUNTY OF Russell, ss.
Harold Wurst, Treasurer (employee of owner) or (owner or operator) of the above-described well,

being first duly sworn on oath, says: That I have knowledge of the facts, statements, and matters herein contained and the log of the above-described well as filed and that the same are true and correct. So help me God.

(Signature) Harold Wurst
Russell, Kansas (Address)

SUBSCRIBED AND SWORN to before me this 6th day of June, 19 50

My commission expires 2-8-54 _____ Notary Public.

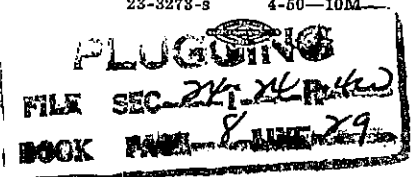

Buffalo Oil Company
Morgan # 1

NW NW SW Sec. 24-24S-4W
Reno County, Kansas

Total Depth: 4027'
Comm: 5-11-50
Comp: 5-28-50

Casing

Cement

8 5/8" Set @ 446'

244 Sacks of Manarch

Formation	Depth:
Sand-Gravel	110
Shale-Shell	150
Sand-Shale	325
Shale-Shells	530
Anhydrite-Shale	710
Shale-Shells	755
Shale-Anhydrite	885
Lime-Shale	1530
Shale-Shells	1600
Red Bed, - Shale	1700
Lime-Shale	2900
Lime	2935
Lime-Shale	3035
Lime	3058
Lime-Shale	3130
Lime	3240
Lime-Shale	3381
Mississippi	3405
Lime-Chert	3578
Mississippi	3591
Lime	3750
Lime-Shale	3905
Simpson-Sand-Shale	3940
Sand-Shale	3980
Arbuckle	4027'

COMMISSIONER
 STATE CORPORATION
 COMMISSION
 KANSAS
 6-9-50

STATE OF KANSAS)
) SS
 RUSSELL COUNTY)

I hereby certify that the above information is true and correct to the best of my knowledge.

Walter Keller

Subscribed and sworn to before me this 6th day of June, 1950.

[Signature]

Notary Public

My commission expires: 2-8-54

