

STATE OF KANSAS
STATE CORPORATION COMMISSION

WELL PLUGGING RECORD

OR

FORMATION PLUGGING RECORD

Strike out upper line when reporting plugging off formations.

Give All Information Completely
Make Required Affidavit
Mail or Deliver Report to:
Conservation Division
State Corporation Commission
800 Bitting Building
Wichita, Kansas

NORTH

		0	

**Locate well correctly on above
Section Plat**

Reno County, Sec. 36 Twp. 24 Rge. 4 (E) W (W)

Location as "NE $\frac{1}{4}$ NW $\frac{1}{4}$ SW $\frac{1}{4}$ " or footage from lines 8/2 NW/4 NW/4 SE/4

Lease Owner..... B & R Drilling Co.

Lease Name.....Blubaugh.....Well No. 1.....

Office Address.....Russell, Ks.

Character of Well (completed as Oil; Gas or Dry Hole)..... **Dry Hole**

Date well completed.....2/18/44.....19

Application for plugging filed 2/18/44 19

Application for plugging approved.....2/18/44.....19

Plugging commenced 2/18/44 1944

Plugging completed.....2/18/44.....19.....

Reason for abandonment of well or producing formation.....Dry Hole.....

If a producing well is abandoned, date of last production.....19.....

Was permission obtained from the Conservation Division or its agents before plugging was commenced? Yes

Name of Conservation Agent who supervised plugging of this well.....Durkee

Producing formation..... Depth to top..... Bottom..... Total Depth of Well 4095 Feet

Show depth and thickness of all water, oil and gas formations.


OIL, GAS OR WATER RECORDS

CASING RECORD

[illegible]

Describe in detail the manner in which the well was plugged, indicating where the mud fluid was placed and the method or methods used in introducing it into the hold. If cement or other plugs were used, state the character of same and depth placed, from.....feet tofeet for each plug set.

Filled with mud to 335'-18 sacks cement @ 335'-filled with mud to 30'-plugged with 7 sacks cement.

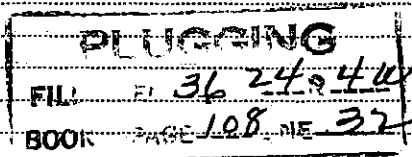

(If additional description is necessary, use BACK of this sheet)

Correspondence regarding this well should be addressed to B & R Drilling Co.
Address Russell, Ks.

STATE OF Kansas, COUNTY OF Russell, ss.
C. L. Roberts (employee of owner) or (owner or operator) of the above-described well,
being first duly sworn on oath, says: That I have knowledge of the facts, statements, and matters herein contained and the log of the above-described well as filed and that the same are true and correct. So help me God.

(Signature)

Russell, Kane
(Address)

(Address)

SUBSCRIBED AND SWORN to before me this 21st day of February, 1944

My commission expires _____

April 16, 1947

19-4174



6-42-6M

Notary Public.

B & R Drilling Co.
Blubaugh #1

Sec. 36 Twp. 14 N. Rge. 4
County: Reno, Kansas

Total Depth: 4095'
Comm: 10/26/43 Comp: 2/18/44

Casing
17 Jts. 10 3/4" Set at 340'

Cement
300 Sacks

Formation:	Depth:	Formation:	Depth:
Sand & Gravel	205'	Shale & Lime	3615'
Soft Sand	240	Chert	3650
Sand & Gravel	310	Chat	3664
Shale & Shells	390	Chert	3694
Sand & Shale	565	Chat	3739
Shale, Lime, & Shells	610	Chat & Chert	3754
Lime	725	Chat	3775
Shale & Shells	890	Chert	3787
Sand & Shale	995	Chat & Chert	3819
Anhydrite & Lime	1031	Chat & Shale	3846
Shale & Shells	1050	Shale	3905
Salt & Shells	1095	Plugged back to 3373	
Shale & Shells	1110	Cement	3574
Shale	1190	Lime & Shale	3603
Anhydrite	1220	Chat	3624
Shale & Shells	1310	Chert	3628
Shale, Lime, & Shells	1400	Chat	3674
Lime	1420	Lime	3719
Lime & Shale	1500	Lime, Chert, & Shale	3734
Shale	1780	Chat	3742
Shale & Lime	2005	Lime	3746
Shale	2210	Chat	3759
Lime	2262	Lime & Shale	3773
Lime & Shale	2237	Lime	3796
Lime	2464	Lime & Shale	3867
Shale	2570	Shale	3913
Lime & Shale	2647	Lime & Shale	3975
Lime	3053	Viola Lime	3995
Shale & Lime	3120	Shale & Sand	4020
Lime	3155	Shale, Sand, & Lime	4043
Lime & Shale	3170	Sand	4052
Gray Lime	3204	Sand & Shale	4079
Lime	3430	Lime	4095
Shale	3485		
Shale & Lime	3515		
Lime & Shells & Shale	3575		

State of Kansas)
Russell County) SS

I hereby certify that the above information is true and correct to the best of my knowledge.

Subscribed and sworn to before me this 21 day of February, 1944.

Margaret Sutcliffe
Notary Public

My commission expires April 16, 1947

