


STATE OF KANSAS
STATE CORPORATION COMMISSION
Give All Information Completely
Make Required Affidavit
Mail or Deliver Report to:
Conservation Division
State Corporation Commission
211 No. Broadway
Wichita, Kansas

WELL PLUGGING RECORD

Reno County. Sec. 13 Twp. 24 Rge. 8 (E) W (W)
Location as "NE/CNW&SW" or footage from lines. SW NE SE
Lease Owner West Supply Co., Inc.
Lease Name Love #3 Well No. _____
Office Address Chase, Kansas
Character of Well (completed as Oil, Gas or Dry Hole) _____
Date well completed _____ 19____
Application for plugging filed _____ 19____
Application for plugging approved _____ 19____
Plugging commenced 11-19-59 _____ 19____
Plugging completed 11-23-59 _____ 19____
Reason for abandonment of well or producing formation _____

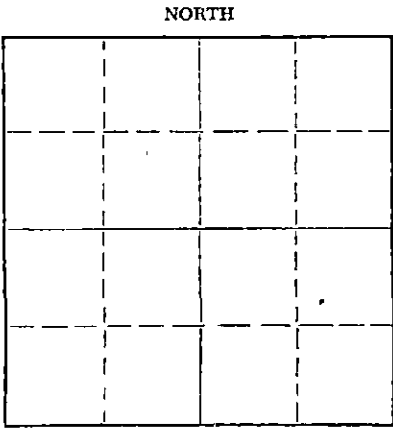

Locate well correctly on above Section Plat

If a producing well is abandoned, date of last production _____ 19____
Was permission obtained from the Conservation Division or its agents before plugging was commenced? yes

Name of Conservation Agent who supervised plugging of this well ~~XXXXXXXXXX~~ Fred Hampel
Producing formation _____ Depth to top _____ Bottom _____ Total Depth of Well 3523 Feet
Show depth and thickness of all water, oil and gas formations.

OIL, GAS OR WATER RECORDS

CASING RECORD

FORMATION	CONTENT	FROM	TO	SIZE	PUT IN	PULLED OUT
				10-3/4"	174'	none
				5-1/2"	3513'	2909'

Describe in detail the manner in which the well was plugged, indicating where the mud fluid was placed and the method or methods used in introducing it into the hole. If cement or other plugs were used, state the character of same and depth placed, from _____ feet to _____ feet for each plug set.

Checked the hole to 3522' and found it open. Filled w/sand to 3490' and dumped 5 sacks of cement with bailer. Pulled 5 1/2" casing. Cleared hole and mudded the hole to 180', then bailed hole to 180', set rock bridge to 170' and dumped 15 sacks of cement. Mudded the hole to 112', set rock bridge to 102' and dumped 10 more sacks of cement. Mudded the hole to 10', set rock bridge and ran 5 sacks of cement to base of cellar.

REC. FILED
STATE CORP. COM.
12-2-59
DEC 2 1959

PLUGGING COMPLETED

CONSERVATION DIVISION
Wichita, Kansas

Name of Plugging Contractor Knight Casing Pulling Co.
Address Chase, Kansas

STATE OF KANSAS, COUNTY OF RICE, ss.
I, Noel J. Knight (employee of owner) or (owner) of the above-described well, being first duly sworn on oath, says: That I have knowledge of the facts, statements, and matters herein contained and the log of the above-described well as filed and that the same are true and correct. So help me God.

(Signature) Noel Knight
Chase, Kansas
(Address)

SUBSCRIBED AND SWORN to before me this 1st day of December, 1959


My commission expires 9-27-62
Thomas V. Dugg
Notary Public.



WELL LOG BUREAU - KANSAS GEOLOGICAL SOCIETY
 412 Union National Bldg. Wichita, Kansas

Company - RALPH N. PARSONS CO. & HERSHFIELD CO. INC. 13
 Farm - 2000 No. 3. 15 T. 24 R. 8 W
 SW NE SE

Total Depth. 3523
 Comm. 2-20-45 Comp. 3-14-45
 Shot or Treated.
 Contractor. Pulse-Hershfield Bldg. Co., Inc.
 Issued. 10-13-45

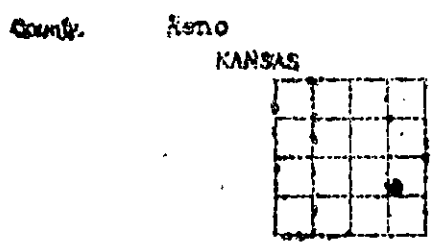

CASING:
 10 3/4"
 5 1/2"
 314' Con.
 3313' Con.

Elevation. _____
 Production. Pot. 50 B

Figures indicate Bottom of Formations.

surface & sand	70
red rock	315
shale blue	976
shale & shells	1258
lime	1290
shale & shells	1536
lime brkn	1665
shale & shells	2390
lime	2437
shale & shells	2640
lime	2665
shale	2703
lime	3000
shale & shells	3164
lime	3403
shale	3442
lime (Rotary T.D.)	3517
lime	3523
Total Depth	

RECEIVED
 STATE CORPORATION COMMISSION

NOV 6 1959

CONSERVATION DIVISION
 Wichita, Kansas

11-6-59

Top of Oil Zone 3515 drilled
 in w/ Rotary 2'.