


WELL PLUGGING RECORD

Give All Information Completely
Make Required Affidavit
Mail or Deliver Report to:
Conservation Division
State Corporation Commission
211 No. Broadway
Wichita, Kansas

NORTH

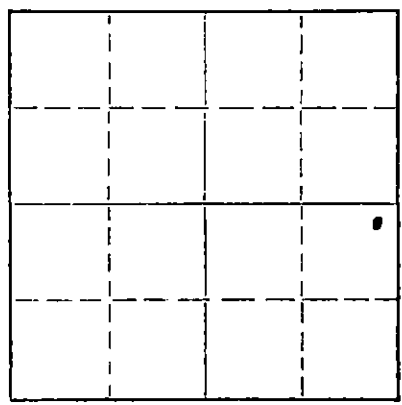

Locate well correctly on above
Section Plat

Reno County. Sec. 18 Twp. 24 Rge. 8 (E) W (W)
Location as "NE/CNW/SW" or footage from lines: NE NE SE
Lease Owner: Solar Oil Company
Lease Name: Fesler
Office Address: 1117 Union National Building Wichita, Kansas
Character of Well (completed as Oil, Gas or Dry Hole): Dry Hole
Date well completed: March 17 19 66
Application for plugging filed: March 17 19 66
Application for plugging approved: March 17 19 66
Plugging commenced: March 17 19 66
Plugging completed: March 17 19 66
Reason for abandonment of well or producing formation: D & A

If a producing well is abandoned, date of last production: 19
Was permission obtained from the Conservation Division or its agents before plugging was commenced? Yes

Name of Conservation Agent who supervised plugging of this well: Gilbert J. Toman, Holyrood, Kansas
Producing formation: Depth to top: Bottom: Total Depth of Well: 3781 Feet
Show depth and thickness of all water, oil and gas formations.

OIL, GAS OR WATER RECORDS

CASING RECORD

FORMATION	CONTENT	FROM	TO	SIZE	PUT IN	PULLED OUT
Surface Casing		0	209	8 5/8	209	None

Describe in detail the manner in which the well was plugged, indicating where the mud fluid was placed and the method or methods used in introducing it into the hole. If cement or other plugs were used, state the character of same and depth placed, from feet to feet for each plug set.

- Plug #1 20 sacks @ 200' through D.P.
- Plug #2 10 sacks @ 40'
- Plug #3 2 sacks in rat hole.

Plugging completed at 10 p.m.

RECEIVED
STATE CORPORATION COMMISSION

APR 5 1966
4-5-66
CONSERVATION DIVISION
Wichita, Kansas

(If additional description is necessary, use BACK of this sheet)
Name of Plugging Contractor: S & S Drilling Co.
Address: Box 645 Great Bend, Kansas

STATE OF Kansas, COUNTY OF Barton, ss.
T. D. Sweetman (employee of owner) or (owner or operator) of the above-described well, being first duly sworn on oath, says: That I have knowledge of the facts, statements, and matters herein contained and the log of the above-described well as filed and that the same are true and correct. So help me God.

(Signature) T. D. Sweetman
Box 645 Great Bend, Kansas (Address)

SUBSCRIBED AND SWORN TO before me this 22 day of March, 19 66

My commission expires 4-27-69
Notary Public.

WELL LOG
SOLAR OIL COMPANY
Fesler #1
NE NE SE 18-24-8
Reno County Kansas

Elevation 1663 DF

<u>FROM</u>	<u>TO</u>	
209	1090	Red Bed and Shale
1090	1235	Shale and Shells
1235	1420	Lime and Shale
1420	1820	Lime
1820	2265	Shale and Lime
2265	2652	Lime and Shale
2652	3100	Lime
3100	3265	Shale
3265	3768	Lime
3768	3781	Miss
3781		TD

Heebner	3062
Lansing KC	3262
Con. Sand	3739
Miss	3769
TD	3781

RECEIVED
STATE CORPORATION COMMISSION
APR 6 1966
4-6-66
CONSERVATION DIVISION
Wichita, Kansas

STATE OF KANSAS

County of Barton ss

T. D. Sweetman, Partner of S & S Drilling Company,
Being First duly sworn on oath says: That I have knowledge of the facts, statements and matters herein contained and the log of the above described well as filed and that the same are true and correct.

T. D. Sweetman

Subscribed and sworn before me this 21st day of March, 1966.

Henry F. Belcher
Notary Public Barton County

My Commission Expires 4-27-69.