


STATE OF KANSAS
STATE CORPORATION COMMISSION

WELL PLUGGING RECORD

Give All Information Completely
Make Required Affidavit
Mail or Deliver Report to:
Conservation Division
State Corporation Commission
212 North Market, Insurance Bldg.
Wichita, Kansas

NORTH

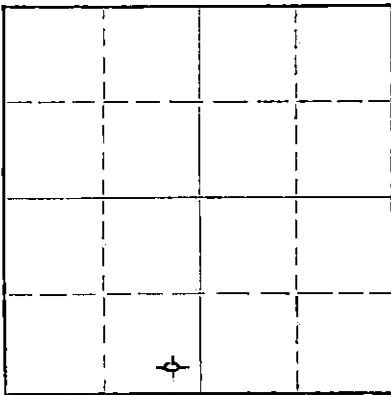

Locate well correctly on above
Section Plat

Reno

County. Sec. 21 Twp. 24S Rge. 8 (E) W (W)

Location as "NE/CNW/SW" or footage from lines SE/4 SE/4 SW/4

Lease Owner Grant Oil Company

Lease Name FOSTER

Well No. 1

Office Address 518 Board of Trade Building, Wichita 2, Kansas

Character of Well (completed as Oil, Gas or Dry Hole) Dry Hole

Date well completed April 28, 19 61

Application for plugging filed (Verbal) April 28, 19 61

Application for plugging approved (Verbal) April 28, 19 61

Plugging commenced April 28, 19 61

Plugging completed April 28, 19 61

Reason for abandonment of well or producing formation Dry Hole

If a producing well is abandoned, date of last production 19

Was permission obtained from the Conservation Division or its agents before plugging was commenced? Yes

Name of Conservation Agent who supervised plugging of this well Fred Hampel

Producing formation Depth to top Bottom Total Depth of Well 3900 Feet

Show depth and thickness of all water, oil and gas formations.

OIL, GAS OR WATER RECORDS

CASING RECORD

FORMATION	CONTENT	FROM	TO	SIZE	PUT IN	PULLED OUT
		0	218'	8-5/8"	218'	none

Describe in detail the manner in which the well was plugged, indicating where the mud fluid was placed and the method or methods used in introducing it into the hole. If cement or other plugs were used, state the character of same and depth placed, from feet to feet for each plug set.

Plugged hole. Hole filled with mud up to 210'
with 15 sacks cement and 1 sack hulls mixed and
poured on bottom. Plug set at 210'. Top plug
set at 40' with 1 sack hulls and 10 sacks cement
on plug. 2 sacks cement in rat hole.

RECEIVED
STATE CORPORATION COMMISSION

MAY 2 1961

CONSERVATION DIVISION
Wichita, Kansas

5-2-61

(If additional description is necessary, use BACK of this sheet)
Name of Plugging Contractor Birmingham-Bartlett Drilling Co.
Address 300 Kaufman Building, Wichita 2, Kansas

STATE OF KANSAS, COUNTY OF SEDGWICK
Richard Hindery, Partner of Birmingham-Bartlett Drilling Co., contractor of the above-described well, being first duly sworn on oath, says: That I have knowledge of the facts, statements, and matters herein contained and the log of the above-described well as filed and that the same are true and correct. So help me God. BIRMINGHAM-BARTLETT DRILLING CO.

(Signature) By Richard Hindery Partner
300 Kaufman Building, Wichita 2, Kansas
(Address)

SUBSCRIBED AND SWORN to before me this 1st day of May, 19 61.

My commission expires October 2, 1962.

Beverly Larson Notary Public.



FOSTER NO. 1 WELL

LOCATION: SE/4 SE/4 SW/4
Section 21-24S-8W
Reno County, Kansas

SPUDDED: 4-18-61
COMPLETED: 4-28-61

OPERATOR: Grant Oil Company
518 Board of Trade Building
Wichita 2, Kansas

CONTRACTOR: Birmingham-Bartlett Drilling Co.
300 Kaufman Building
Wichita 2, Kansas

SURFACE CASING: 8-5/8" 17# slip joint casing cemented
at 218' with 175 sacks cement and 3 cc

OIL STRING: None set. Dry hole. Plugged on 4-28-61.

LOG

(Figures indicate bottom of formation)

0 -	80	Sand
	217	Red bed
	219	Anhydrite
	1210	Shale and shells
	2665	Lime and shale
	2750	Lime
	2908	Shale and lime
	3100	Shale and shells
	3320	Shale and lime
	3363	Lime
	3430	Shale and lime
	3550	Lime
	3800	Lime and shale
	3812	Lime
	3859	Lime and shale
	3900	Arbuckle
	3900	Rotary total depth

RECEIVED
MAY 2 1961
CONSERVATION DIVISION
Wichita, Kansas
5-2-61

The undersigned, Richard Hindery, one of the partners of Birmingham-Bartlett Drilling Co., hereby certifies that the above is a true and correct log of the Foster No. 1 Well as shown in the daily drilling reports.

BIRMINGHAM-BARTLETT DRILLING CO.

By Richard Hindery
Richard Hindery, Partner

Subscribed and sworn to before me
this 1st day of May, 1961.

Beverly Larson
Beverly Larson, Notary Public
My commission expires October 2, 1962