


STATE OF KANSAS
STATE CORPORATION COMMISSION

WELL PLUGGING RECORD

Give All Information Completely
Make Required Affidavit
Mail or Deliver Report to:
Conservation Division
State Corporation Commission
211 No. Broadway
Wichita, Kansas

NORTH

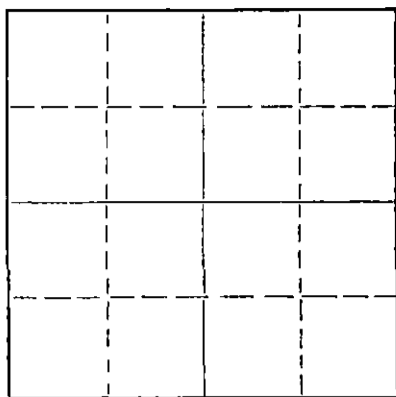

Locate well correctly on above
Section Plat

Stafford County. Sec. 12 Twp. 25S Rge. 14 (NW) (W)
Location as "NE/CNWxSWx" or footage from lines. NW/NW/NE
Lease Owner Home Stake Production Co.
Lease Name Bowker Well No. #1
Office Address Philtower Bldg., Tulsa, Oklahoma
Character of Well (completed as Oil, Gas or Dry Hole) _____
Date well completed _____ 19____
Application for plugging filed Yes 19____
Application for plugging approved Yes 19____
Plugging commenced 9-27 1958
Plugging completed 10-4 1958
Reason for abandonment of well or producing formation _____

If a producing well is abandoned, date of last production _____ 19____
Was permission obtained from the Conservation Division or its agents before plugging was commenced? Yes

Name of Conservation Agent who supervised plugging of this well Mr. Frank Broadfoot
Producing formation _____ Depth to top _____ Bottom _____ Total Depth of Well 4310' Feet
Show depth and thickness of all water, oil and gas formations.

OIL, GAS OR WATER RECORDS

CASING RECORD

FORMATION	CONTENT	FROM	TO	SIZE	PUT IN	PULLED OUT
				8 5/8"	Surface	
				5 1/2"		3,010'

Describe in detail the manner in which the well was plugged, indicating where the mud fluid was placed and the method or methods used in introducing it into the hole. If cement or other plugs were used, state the character of same and depth placed, from _____ feet to _____ feet for each plug set.

Measured into T.D. 4310'.
Plugging started 9-27-58. Finished 10-4-58.
Plugged off bottom and dumped 5 sacks cement. Loaded hole with water.
Shot pipe. Pumped in 40 bbls water and 60 bbls oil. Layed down pipe
and squeezed well as follows: Pumped in 20 sacks mud and 75 sacks
cement. Well completed.

RECEIVED
STATE CORPORATION COMMISSION

OCT 23 1958

CONSERVATION DIVISION
WICHITA, KANSAS

10-23-58

(If additional description is necessary, use BACK of this sheet)
Name of Plugging Contractor J.O. Forbes d/b/a Forbes Casing Pulling Co.
Address Box 221, Great Bend, Kansas

STATE OF Kansas, COUNTY OF Barton, ss.
J.O. Forbes (employee of owner) or (owner or operator) of the above-described well, being first duly sworn on oath, says: That I have knowledge of the facts, statements, and matters herein contained and the log of the above-described well as filed and that the same are true and correct. So help me God.

(Signature) J. O. Forbes
Box 221, Great Bend, Kans. (Address)

SUBSCRIBED AND SWORN TO before me this 8th day of October, 1958

Betty S. Edman
Notary Public.

My commission expires November 8, 1960.

PLUGGING
FILE SEC. 12 T. 25 R. 14 W.
BOOK PAGE 120 LINE 33

HOME-STAKE PRODUCTION COMPANY
 PHILTOWER BUILDING
 TULSA, OKLAHOMA

FARM NAME Bowker
 COUNTY Stafford
 SEC.12 TWP25SRGE14W
 WELL LOCATION:

WELL NO. 1
 STATE Kansas

NW NW NE

ELEVATION: 1956 DF 1953 GR
 CHARACTER OF WELL: Dry Hole
 COMMENCED DRILLING: February 9, 1958
 COMPLETED ~~DRILLING~~: April 7, 1958
 CASING RECORD:

8-5/8" - 282'
 5-1/2" - 4160'

CEMENTING RECORD:

Cemented 282' of 8-5/8" casing with 250 sacks of regular cement.
 Cemented 4160' of 5-1/2" casing with 225 sacks Posmix

SHOT RECORD: Perforated 3802 - 08 with 24 shots. (squeezed and re-perforated
 Perforated 3788 - 88 1/2 with 8 shots same area)

TYPE OF TOOLS: Rotary

 FORMATION RECORD

Shale	-0-	800	
Shale and anhydrite	800	1300	
Shale & lime	1300	1500	
Shale and gypsum	1500	1950	
Lime & shale	1950	2600	
Lime and sandy shale	2600	3525	
Shale	3525	3660	
Limestone	3660	3950 Kansas City Lime from 3802 to 3808
Shale & lime	3950	4000	
Chat	4000	4040	
Shale	4040	4100	
Chert & lime	4100	4260	
Sand & shale	4260	4305	
Dolomite	4305	4310	
 Total Depth	 4310		

RECEIVED
 STATE CORPORATION COMMISSION

JUN 28 1958

DIVISION

PLUGGING	
FILE	SEC. 12 T. 25 R. 14W
BOOK	PAGE 120 LINE 33