


STATE OF KANSAS
STATE CORPORATION COMMISSION

WELL PLUGGING RECORD

Give All Information Completely
Make Required Affidavit
Mail or Deliver Report to
Conservation Division
State Corporation Comm.
245 North Water
Wichita, KS 67202

Stafford County. Sec. 12 Twp. 25 Rge. 14 N/W
Location as "NE/CNW SW 1/4" or footage from lines
NE SE SW

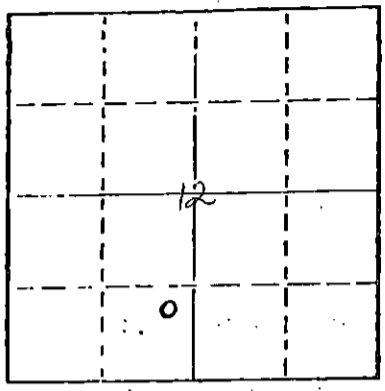

Locate well correctly on above
Section Plat

Lease Owner Cities Service Oil Co.
Lease Name Kachelman "A" (Washdown) Well No. 1
Office Address 700 Sutton Place Bldg., Wichita, Ks. 67202
Character of Well (Completed as Oil, Gas or Dry Hole) Dry Hole

Date Well completed March 18, 1978
Application for plugging filed (verbally) March 18, 1978
Application for plugging approved (verbally) March 18, 1978
Plugging commenced March 18, 1978
Plugging completed March 18, 1978

Reason for abandonment of well or producing formation
No commercial quantity of oil or gas encountered
If a producing well is abandoned, date of last production
19

Was permission obtained from the Conservation Division or
its agents before plugging was commenced? Yes

Name of Conservation Agent who supervised plugging of this well Bill Owens
Producing formation _____ Depth to top _____ Bottom _____ Total Depth of Well 3220
Show depth and thickness of all water, oil and gas formations.

OIL, GAS OR WATER RECORDS

CASING RECORD

FORMATION	STATE	CONTENT	FROM	TO	SIZE	PUT IN	PULLED OUT

RECEIVED
APR 12 1978
STATE CORPORATION COMMISSION
CONSERVATION DIVISION
WICHITA, KANSAS

4-12-78

Describe in detail the manner in which the well was plugged, indicating where the mud fluid
was placed and the method or methods used in introducing it into the hold. If cement or other
plugs were used, state the character of same and depth placed, from _____ feet to
_____ feet for each plug set.


Set 1st plug at 540' with 40 sacks
2nd plug at 280' with 35 sacks
3rd plug at 40' with 12 sacks
35 sacks in rathole.
Cemented with Halliburton Common Cement

(If additional description is necessary, use BACK of this sheet)

Name of Plugging Contractor Abercrombie Drilling, Inc.

STATE OF KANSAS COUNTY OF SEDGWICK ss.
Jack L. Partridge, Ass't. Sec.-Treas. (employee of owner) or (owner or operator) of the above-described
well, being first duly sworn on oath, says: That I have knowledge of the facts, statements, and matters herein contained and the log of the
above-described well as filed and that the same are true and correct. So help me God.

(Signature) Jack L. Partridge
801 Union Center, Wichita, Kansas 67202
(Address)

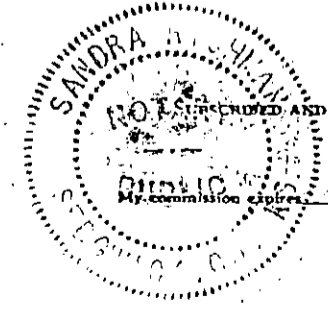

Subscribed and sworn to before me this 11th day of April, 19 78
Sandra Richman
Sandra Richman Notary Public