

STATE OF KANSAS
STATE CORPORATION COMMISSION

Give All Information Completely
Make Required Affidavit
Mail or Deliver Report to:
Conservation Division
State Corporation Commission
211 No. Broadway
Wichita, Kansas

WELL PLUGGING RECORD

STAFFORD County. Sec. 19 Twp. 25S Rge. 14W (E) (W)

Location as "NE/CNW%SW%" or footage from lines 210' NORTHEAST OF NE SW

Lease Owner WESTERN PETROLEUM CO., INC.

Lease Name BOYLAN #1 Well No.

Office Address 925 PATTON ROAD, GREAT BEND, KANSAS

Character of Well (completed as Oil, Gas or Dry Hole) DRY HOLE

Date well completed 8/18 1963

Application for plugging filed 8/19 1963

Application for plugging approved 8/19 1963


Plugging commenced 9:00 A.M. 8/19 1963

Plugging completed 11:30 A.M. 8/19 1963

Reason for abandonment of well or producing formation DRY HOLE

If a producing well is abandoned, date of last production 19

Was permission obtained from the Conservation Division or its agents before plugging was commenced?

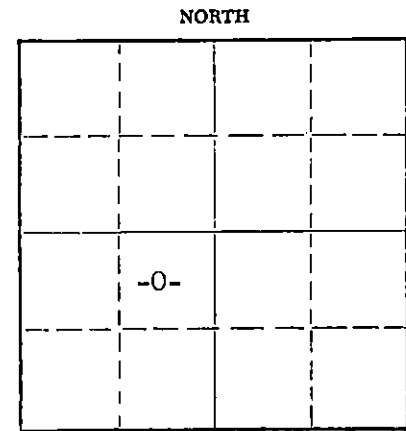

Locate well correctly on above Section Plat

Name of Conservation Agent who supervised plugging of this well ARCHIE V. ELVING

Producing formation Depth to top Bottom Total Depth of Well 4350 Feet

Show depth and thickness of all water, oil and gas formations.

OIL, GAS OR WATER RECORDS

CASING RECORD

FORMATION	CONTENT	FROM	TO	SIZE	PUT IN	PULLED OUT
		-0-	316	8-5/8"		

Describe in detail the manner in which the well was plugged, indicating where the mud fluid was placed and the method or methods used in introducing it into the hole. If cement or other plugs were used, state the character of same and depth placed, from feet to feet for each plug set.

FILLED HOLE TO 300' WITH ROTARY MUD. PUSHED WOODEN PLUG AND 1/4 SXS. HULLS TO FLUID.

CEMENTED WITH 20 SXS. CEMENT THROUGH DRILL PIPE. FILLED HOLE TO 40' WITH ROTARY MUD.

PUSHED WOODEN PLUG AND 1/4 SXS. HULLS TO FLUID. CEMENTED WITH 10 SXS. CEMENT.

RECEIVED
STATE CORPORATION COMMISSION

AUG 23 1963 8-23-63

CONSERVATION DIVISION
Wichita, Kansas

(If additional description is necessary, use BACK of this sheet)

Name of Plugging Contractor

Address

STATE OF KANSAS, COUNTY OF BARTON, ss.

F. L. COPELAND

(employee of owner) or (owner or operator) of the above-described

well, being first duly sworn on oath, says: That I have knowledge of the facts, statements, and matters herein contained and the log of the above-described well as filed and that the same are true and correct. So help me God.

(Signature) F. L. Copeland

925 PATTON ROAD, GREAT BEND, KANSAS
(Address)

SUBSCRIBED AND SWORN TO before me this 20TH day of AUGUST, 19 63.

Ruth M. Kruckenberg
RUTH M. KRUCKENBERG Notary Public.

My commission expires JUNE 13, 1966

DRILLERS LOG
BOYLAN #1

CASING RECORD:
5 JTS. 8-5/8"
20# CASING

COMPANY: WESTERN PETROLEUM CO., INC.
CONTRACTOR: WESTERN PETROLEUM CO., INC.

TOTAL DEPTH:
4350'

COMMENCED: AUGUST 7, 1963
COMPLETED: AUGUST 18, 1963
ELEVATION: 1993 KB
1991 DF

DESCRIPTION:
C. NE SW
SECTION 19-T25S-R14W
STAFFORD COUNTY, KANSAS

FORMATION	FROM	TO	REMARKS
SOIL, SAND, SHELLS	0	260	SPUDED @ 4:45 P.M., 8/7/63. RAN 5 JTS. 20# NEW PIPE, (310.54). SET @ 317'.
RED BED AND SHELLS	260	318	
RED BED	318	922	CEMENTED WITH 300 SXS. COMMON CEMENT, 2% GEL, 5 SXS. CC, 4 SXS. AC. PLUG DOWN @ 3:30 A.M., 8/8/63. CEMENT CIRCULATED.
ANHYDRITE	922	940	
RED BED, SHALE, SHELLS	940	1245	DST #1, 4187-4225'. OPEN 40 MINUTES, WEAK BLOW FOR 9 MINUTES. RECOVERED 12' DRILLING MUD. NO SHOWS. 1BHP 0#/30 MIN.; FBHP 0#/30 MIN.; IFP-FFP 0#; HH 2015#.
SHALE AND SHELLS	1245	1715	
SHALE, SHELL, RED BED	1715	2065	D & A, 8/18/63.
SHALE AND LIME	2065	2215	
LIME AND SHALE	2215	2455	
SHALE AND LIME	2455	2570	
LIME AND SHALE	2570	2674	
SHALE AND LIME	2674	2799	
LIME AND SHALE	2799	2939	
SHALE AND LIME	2939	3155	
LIME AND SHALE	3155	3283	
SHALE AND LIME	3283	3410	
LIME AND SHALE	3410	3460	
LIME	3460	3607	
LIME AND SHALE	3607	3755	
LIME	3755	4208	
CHERT	4208	4225	
LIME AND SHALE	4225	4260	
SHALE	4260	4276	
CHERT	4276	4303	
CHERT AND LIME	4303	4332	
LIME	4332	4350	
RTD	4350		

RECEIVED
STATE CORPORATION COMMISSION

AUG 27 1963

CONSERVATION DIVISION
Wichita, Kansas

LOG TOPS

ANHYDRITE	934	1059
HEEBNER	3606	-1603
LANSING	3778	-1785
B/KC	4060	-2067
MISSISSIPPI	4216	-2223
KINDERHOOK	4225	-2232
VIOLA	4277	-2284
TD	4350	-2357

STATE OF KANSAS)
COUNTY OF BARTON)

I, THE UNDERSIGNED, BEING DULY SWORN ON OATH, STATE THAT THE ABOVE STATEMENT AND LOG ARE TRUE AND A CORRECT RECORD AND LOG OF THE WELL DRILLED AT THE LOCATION ABOVE DESCRIBED.

WESTERN PETROLEUM CO., INC.

F. L. Copeland
F. L. COPELAND, DRILLING SUPT.

SUBSCRIBED AND SWORN TO BEFORE ME THIS 22ND DAY OF AUGUST, 1963.

Ruth M. Kruckenberg
RUTH M. KRUCKENBERG, NOTARY PUBLIC

MY COMMISSION EXPIRES JUNE 13, 1966.