


STATE OF KANSAS
STATE CORPORATION COMMISSION

WELL PLUGGING RECORD

Give All Information Completely
Make Required Affidavit
Mail or Deliver Report to:
Conservation Division
State Corporation Commission
211 No. Broadway
Wichita, Kansas

Stafford County. Sec. 19 Twp. 25S Rge. 14 W (W)
Location as "NE/CNW/SW" or footage from lines SE SE SE
Lease Owner D. R. Lauck Oil Company, Inc.
Lease Name Smith "B" Well No. 1
Office Address 301 South Broadway Wichita 2 Kans
Character of Well (completed as Oil, Gas or Dry Hole) dry hole
Date well completed August 20 19 57
Application for plugging filed August 20 19 57
Application for plugging approved August 20 19 57
Plugging commenced August 20 19 57
Plugging completed August 20 19 57
Reason for abandonment of well or producing formation dry hole

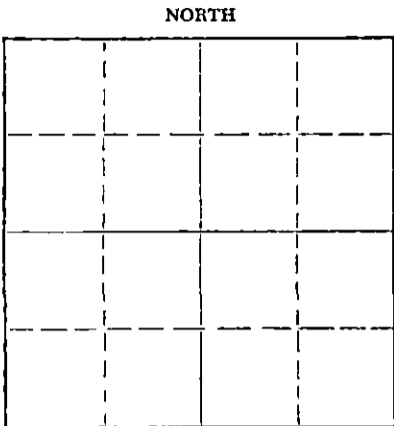

Locate well correctly on above
Section Plat

If a producing well is abandoned, date of last production _____ 19 ____
Was permission obtained from the Conservation Division or its agents before plugging was commenced? yes

Name of Conservation Agent who supervised plugging of this well R. M. Brundage
Producing formation _____ Depth to top _____ Bottom _____ Total Depth of Well 4570 Feet
Show depth and thickness of all water, oil and gas formations.

OIL, GAS OR WATER RECORDS

CASING RECORD

FORMATION	CONTENT	FROM	TO	SIZE	PUT IN	PULLED OUT
		0	238	8 5/8"	238	none

Describe in detail the manner in which the well was plugged, indicating where the mud fluid was placed and the method or methods used in introducing it into the hole. If cement or other plugs were used, state the character of same and depth placed, from _____ feet to _____ feet for each plug set.

<u>Hole filled with mud</u>	<u>4570 - 210</u>
<u>plug</u>	<u>210 - 206</u>
<u>cement</u>	<u>206 - 40</u>
<u>mud-hulls</u>	<u>40 - 20</u>
<u>plug</u>	<u>20 - 16</u>
<u>cement</u>	<u>16 - 6' bottom of cellar</u>

RECEIVED
STATE CORPORATION COMMISSION

AUG 24 1957

CONSERVATION DIVISION
Wichita, Kansas

8-24-57

(If additional description is necessary, use BACK of this sheet)
Name of Plugging Contractor Globe Cementing Company
Address Great Bend Kansas

STATE OF Kansas, COUNTY OF Sedgwick SS.
John H. Knightley (employee of owner) by John H. Knightley of the above-described well, being first duly sworn on oath, says: That I have knowledge of the facts, statements, and matters herein contained and the log of the above-described well as filed and that the same are true and correct. So help me God.
(Signature) John H. Knightley
(Address) Wichita, Kans

SUBSCRIBED AND SWORN TO before me this 23 day of August, 19 57

My commission expires Sept. 14 1959

Elizabeth Gay
Notary Public.

PLUGGING
FILE SEC. 19 T. 25 R. 14 W
BOOK PAGE 39 LINE 16

D. E. Lauck Oil Company, Inc.

Smith B-1

SE SE SE Sec. 19-25S-14W
Stafford County Kansas

Commenced: August 6, 1957
Completed: August 20, 1957

Casing Record: 238' 8 5/8" cemented w/225 sx

Elevation: GR 1995; DF 1998; 2000 KB

Drillers Log

Sand & clay	180
Red Bed	460
sand	480
shale & shells	1900
shale & Lime	2205
Brown Lime & shale	2380
shale & lime	2905
Broken Lime & shale	3090
shale & lime	3320
Broken lime	3425
lime & shale	3622
lime	3685
lime & shale	3847
lime	4293
lime & shale	4271
shale	4310
shale & lime	4372
shale & chert	4384
chert & lime	4405
lime	4433
lime & chert	4461
lime, chert & shale	4499
shale & lime	4533
lime (Arbuckle)	4570 RTD

	<u>Tops</u>	
	<u>Sample</u>	<u>Schlumberger</u>
Anhydrite		907+1093
Heebner	3624-1624	3620-1620
Toronto	3645-1645	3643-1643
Douglas	3665-1665	3664-1664
Brown Lime	3766-1766	3764-1764
Lansing KB	3798-1793	3792-1792
Base KC	4113-2113	4100-2100
Mississippi	4241-2241	4238-2238
Kinderhook	4256-2256	4257-2257
Viola	4384-2384	4378-2378
Simpson	4474-2474	4473-2473
Arbuckle	4529-2529	4528-2528
Rotary T.D.	4570-2570	4569-2569

DST #1 (M-D) 4242-4250
weak intermittent blow 35 min.
open 45 min. recovered 25' mud;
FPP# BHP 885#, 30 min.

D & A

RECEIVED
STATE CORPORATION COMMISSION

AUG 24 1957
CONSERVATION DIVISION
Wichita, Kansas

PLUGGING
FILE SEC <u>19</u> T <u>25</u> R <u>14W</u>
BOOK PAGE <u>39</u> LINE <u>16</u>