


WELL PLUGGING RECORD

Give All Information Completely
Make Required Affidavit
Mail or Deliver Report to:
Conservation Division
State Corporation Commission
211 No. Broadway
Wichita, Kansas

Stafford County. Sec. 19 Twp. 25S Rge. 14W (E) (W)
Location as "NE/CNW/SW" or footage from lines C NW NE
Lease Owner Hinkle Oil Company
Lease Name Grunder No. 1 Well No. 1
Office Address 1016 Union Center Bldg., Wichita, Ks.
Character of Well (completed as Oil, Gas or Dry Hole) D&A
Date well completed March 15 19 63
Application for plugging filed March 15 19 63
Application for plugging approved March 15 19 63
Plugging commenced March 15 19 63
Plugging completed March 15 19 63
Reason for abandonment of well or producing formation D&A

NORTH

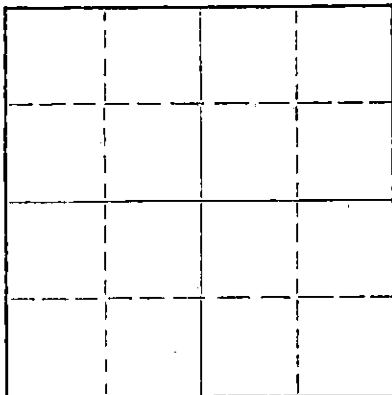

Locate well correctly on above
Section Plat

If a producing well is abandoned, date of last production 19
Was permission obtained from the Conservation Division or its agents before plugging was commenced? Yes

Name of Conservation Agent who supervised plugging of this well Archie V. Elving
Producing formation _____ Depth to top _____ Bottom _____ Total Depth of Well 4259' Feet
Show depth and thickness of all water, oil and gas formations.

OIL, GAS OR WATER RECORDS

CASING RECORD

FORMATION	CONTENT	FROM	TO	SIZE	PUT IN	PULLED OUT
				8 5/8"	253'	-0-

Describe in detail the manner in which the well was plugged, indicating where the mud fluid was placed and the method or methods used in introducing it into the hole. If cement or other plugs were used, state the character of same and depth placed, from _____ feet to _____ feet for each plug set.

Filled hole with mud up to
250' plug. 1/4 sx hulls 25 sx
cement, filled hole up to
40' set plug 1/4 sx hulls,
15 sx cement.

RECEIVED
STATE CORPORATION COMMISSION
MAR 22 1963
CONSERVATION DIVISION
Wichita, Kansas

(If additional description is necessary, use BACK of this sheet)

Name of Plugging Contractor Red Tiger Drilling Co.
Address Box 173--Russell, Kansas

STATE OF KANSAS, COUNTY OF SEDGWICK, ss.

George A. Angle (owner or operator) of the above-described well, being first duly sworn on oath, says: That I have knowledge of the facts, statements, and matters herein contained and the log of the above-described well as filed and that the same are true and correct. So help me God.

(Signature) George A. Angle
580 Fourth Natl. Bank Bldg, Wichita, Ks.
(Address)

SUBSCRIBED AND SWORN TO before me this 19th day of March, 19 63

My commission expires

11-17-66

Daphne V. Head
Notary Public.

DRILLERS LOG

Grunder No. 1

CASING RECORD: 8 5/8" O 253' w/280 sx cement
 COMPANY: Hinkle Oil Company
 CONTRACTOR: Red Tiger Drilling Co.
 COMMENCED: March 4, 1963
 COMPLETED: March 15, 1963

DESCRIPTION: C NW NE
 19-253-14W
 Stafford
 Co., Kans.

ELEVATION:

TOTAL DEPTH: 4259'

<u>FORMATION</u>	<u>FROM</u>	<u>TO</u>	<u>REMARKS</u>
Sod & Sand	0	195	
Blue Shale	195	255	
Red Bed	255	265	
Anhydrite & Shells	265	285	
Shale Shells & Red Bed	285	925	
Anhydrite	925	965	
Shale & Shells	965	1612	
Shale	1612	1800	
Shale w/Lime	1800	3205	
Lime	3205	3222	
Lime & Shale	3222	3375	
Lime	3375	4170	
Lime & Chert	4170	4210	
Lime	4210	4215	
Lime Shale & Chert	4215	4241	
Lime	4241	4259	

RECEIVED
STATE CORPORATION COMMISSION

MAR 22 1963

CONSERVATION DIVISION
Wichita, Kansas

I certify that this is a true and correct copy of the above log to the best of my knowledge.

RED TIGER DRILLING CO.

George A. Angle
George A. Angle

Subscribed and sworn to before me this 19th day of March, 1963.

Daniel V. Head
Notary Public

My Commission Expires:

11-17-66