


STATE OF KANSAS  
STATE CORPORATION COMMISSION

## WELL PLUGGING RECORD

Give All Information Completely

Make Required Affidavit

Mail or Deliver Report to  
Conservation Division  
State Corporation Comm.  
245 North Water  
Wichita, KS 67202

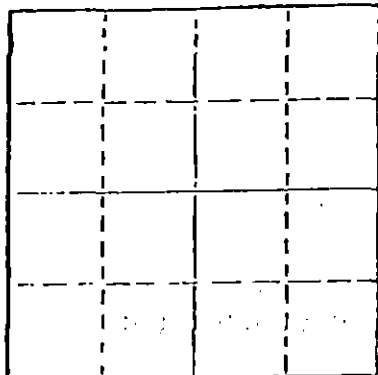

Locate well correctly on above  
Section Plot

Stafford County. Sec. 21 Twp. 25S Rge. 14W E/W  
Location as "NE/CNW $\frac{1}{4}$ SW $\frac{1}{4}$ " or footage from lines NW SW

Lease Owner Donald T. Ingling

Lease Name English Well No. 1

Office Address 1018 First Nat'l Bldg., Wichita, Ks.

Character of Well (Completed as Oil, Gas or Dry Hole)

Dry Hole

Date Well completed June 14, 1976

Application for plugging filed Verbal Application 19

Application for plugging approved Verbal Approval 19

Plugging commenced June 14, 1976

Plugging completed June 14, 1976

Reason for abandonment of well or producing formation

If a producing well is abandoned, date of last production  
19

Was permission obtained from the Conservation Division or  
its agents before plugging was commenced? Yes

Name of Conservation Agent who supervised plugging of this well Leo F. Massey  
Producing formation Depth to top Bottom Total Depth of Well 4,255'

Show depth and thickness of all water, oil and gas formations.

OIL, GAS OR WATER RECORDS

CASING RECORD

| FORMATION | STATE | CONTENT | FROM | TO | SIZE   | PUT IN | PULLED OUT |
|-----------|-------|---------|------|----|--------|--------|------------|
|           |       |         |      |    | 8-5/8" | 284'   | None       |

Describe in detail the manner in which the well was plugged, indicating where the mud fluid was placed and the method or methods used in introducing it into the hold. If cement or other plugs were used, state the character of same and depth placed, from feet to feet for each plug set.

Filled hole with heavy rotary mud from 4,255 ft. to 255 ft. Set plug

at 255 ft. and cemented with 25 sxs cement. Filled hole with heavy

rotary mud from 255 ft. to 40 ft. Set solid plug at 40 ft. and

cemented to cellar with 10 sxs cement, 2 sxs cement in rat hole.

(If additional description is necessary, use BACK of this sheet)

Name of Plugging Contractor H-30, Inc.  
200 North Main, Wichita, Kansas 67202

STATE OF Kansas

COUNTY OF Sedgwick

I, Dean Britting, Agent

(As Agent of owner of the above-described

well, being first duly sworn on oath, says: That I have knowledge of the facts, statements, and matters herein contained and the log of the  
above-described well as filed and that the same are true and correct. So help me God.

(Signature)

200 No. Main, Wichita, Kansas 67202  
(Address)

Subscribed and sworn to before me this 17th day of June, 1976

My commission expires June 30, 1978

Elsie Willison

Notary Public.

KANSAS GEOLOGICAL SOCIETY API # - 15-185-20,659  
KANSAS WELL LOG BUREAU - KANSAS WELL SAMPLE BUREAU  
KANSAS GEOLOGICAL SOCIETY BUILDING  
508 EAST MURDOCK - WICHITA, KANSAS

COMPANY Donald T. Ingling

SEC. 21 T. 25S R. 14W  
LOC. NW SW

FARM English

NO. 1

TOTAL DEPTH 4,255'  
COMM. June 3, 1976

COMP. June 14, 1976


COUNTY Stafford

SHOT OR TREATED

CONTRACTOR H-30, Inc.

ISSUED June 17, 1976

KANSAS

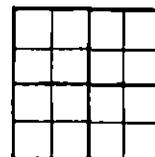

CASING

|    |                                       |
|----|---------------------------------------|
| 20 | 10                                    |
| 15 | 8-5/8" 284' cemented w/250 sxs cement |
| 12 | 6                                     |
| 13 | 5                                     |

ELEVATION 1,991' K.B.

PRODUCTION

FIGURES INDICATE BOTTOM OF FORMATIONS

|                      |        |
|----------------------|--------|
| Sand, Clay and Shale | 284'   |
| Red Bed and Shale    | 890'   |
| Anhydrite            | 900'   |
| Shale                | 1,965' |
| Shale and Lime       | 2,140' |
| Lime and Shale       | 2,478' |
| Shale and Lime       | 2,600' |
| Lime and Shale       | 2,870' |
| Shale and Lime       | 2,990' |
| Lime and Shale       | 3,208' |
| Shale and Lime       | 3,258' |
| Lime and Shale       | 3,472' |
| Shale and Lime       | 3,563' |
| Lime                 | 4,255' |
| Rotary Total Depth   | 4,255' |

I hereby certify the above and foregoing  
to be a true and correct log of the above  
described well as shown by the drilling  
reports.

H-30, INC.

*Sean Britting*  
Sean Britting

State of Kansas

County of Sedgwick

SS:

Subscribed and Sworn to before me a Notary  
Public in and for said county and state  
this 17th. day of June, 1976.



My Commission Expires:

June 30, 1978

*Elsie Willison*  
Elsie Willison - Notary Public

JUN 18 1976

RECORDED BY SCA  
Wichita, Kansas