


STATE OF KANSAS  
STATE CORPORATION COMMISSION

WELL PLUGGING RECORD

Give All Information Completely  
Make Required Affidavit  
Mail or Deliver Report to:  
Conservation Division  
State Corporation Commission  
800 Bitting Building  
Wichita, Kansas

NORTH

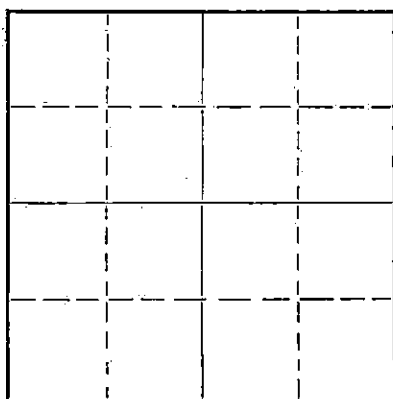

Locate well correctly on above  
Section Flat

Stafford County. Sec. 21 Twp. 25 Rge. 14 (E) (W)  
Location as "NE/CNW/4SW/4" or footage from lines NW/4 NE/4 NW/4  
Lease Owner Falcon Drilling Company, Inc.  
Lease Name Wilson Well No. 1  
Office Address 300 Schweiter Building, Wichita, Kansas  
Character of Well (completed as Oil, Gas or Dry Hole) Dry hole  
Date well completed December 29 19 60  
Application for plugging filed December 29 19 60  
Application for plugging approved December 29 19 60  
Plugging commenced December 29 19 60  
Plugging completed December 29 19 60  
Reason for abandonment of well or producing formation Dry Hole

If a producing well is abandoned, date of last production 19  
Was permission obtained from the Conservation Division or its agents before plugging was commenced? Yes

Name of Conservation Agent who supervised plugging of this well Frank Broadfoot  
Producing formation Depth to top Bottom Total Depth of Well 4160 Feet  
Show depth and thickness of all water, oil and gas formations.

OIL, GAS OR WATER RECORDS

CASING RECORD

Formation	Content	From	To	Size	Put In	Pulled Out
Surface Pipe		0	265'	8 5/8		

Describe in detail the manner in which the well was plugged, indicating where the mud fluid was placed and the method or methods used in introducing it into the hole. If cement or other plugs were used, state the character of same and depth placed, from feet to feet for each plug set.

Fill hole with heavy drilling mud to 240', set plug, 1/2 sack hulls on plug and 20 sacks cement. Fill hole with heavy drilling mud to 35', set plug, 1/2 sack hulls on top of plug, and 10 sacks of cement.

STAMP: 21501 1-12-61  
CONSERVATION DIVISION  
Wichita, Kansas

(If additional description is necessary, use BACK of this sheet)

Correspondence regarding this well should be addressed to  
Address:

STATE OF Kansas, COUNTY OF Sedgwick, ss.  
Jack D. Dunne (employee or owner) of the above-described well,  
being first duly sworn on oath, says: That I have knowledge of the facts, statements, and matters herein contained and the log of the above-described well as filed and that the same are true and correct. So help me God.

(Signature) Jack D. Dunne  
300 Schweiter Building, Wichita, Ks.  
(Address)

SUBSCRIBED AND SWORN to before me this 11th day of January, 19 61

Doris Nilles  
Doris Nilles Notary Public

My commission expires 1-14-64

DRILLER'S LOG

OPERATOR: Falcon Drilling Company, Inc.  
CONTRACTOR: Dunne-Gardner Drilling Co., Inc.  
300 Schweiter Building  
Wichita 2, Kansas  
LEASE: Wilson  
WELL: No. 1  
LOCATION: NW NE NW Section 21, Township 25 South,  
Range 14 West, Stafford County, Kansas  
DATE COMM: December 18, 1960  
DATE COMPL: December 29, 1960  
CASING: Set 8 5/8" @ 265' with 200 sacks cement

<u>FROM</u>	<u>TO</u>	
0	185	Sand
185	260	Shale
260	736	Shale-Red Bed
736	764	Anhydrite
764	1810	Shale-Shells
1810	3750	Shale-Lime
3750	4160	Lime
4160	T.D.	

RECEIVED  
STATE COMMISSION

JAN 12 1961

CONSERVATION DIVISION  
Wichita, Kansas

I certify the above to be true and correct to the best of my knowledge and belief.

DUNNE-GARDNER DRILLING CO., INC.

By Jack D. Dunne

Subscribed and sworn before me this 11th day of January, 1961.

Martha Gorges  
Notary Public

My Commission Expires:

12-14-61