


STATE OF KANSAS
STATE CORPORATION COMMISSION

Give All Information Completely
Make Required Affidavit
Mail or Deliver Report to:
Conservation Division
State Corporation Commission
211 No. Broadway
Wichita, Kansas

WELL PLUGGING RECORD

NORTH

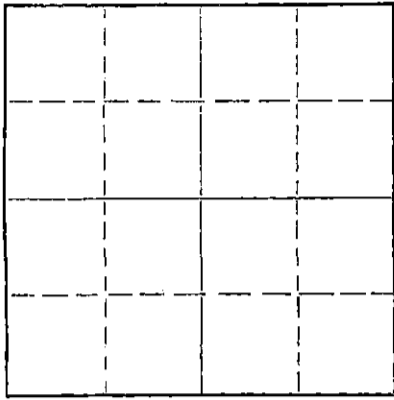

Locate well correctly on above
Section Plat

Stafford County, Sec. 23 Twp. 25 Rge. 14 (B) (W)

Location as "NE/CNW%SW%" or footage from lines SW SW SW
Lease Owner Time Petroleum Company
Lease Name Kipp Well No. 1
Office Address 560 North Fourth National Bank Bldg. Wichita, Ks
Character of Well (completed as Oil, Gas or Dry Hole) Dry Hole
Date well completed Oct 27 19 61
Application for plugging filed Oct 27 19 61
Application for plugging approved Oct 27 19 61
Plugging commenced Oct 27 19 61
Plugging completed Oct 27 19 61
Reason for abandonment of well or producing formation Dry & Abandoned

If a producing well is abandoned, date of last production 19
Was permission obtained from the Conservation Division or its agents before plugging was commenced? Yes

Name of Conservation Agent who supervised plugging of this well W. L. Lackamp
Producing formation _____ Depth to top _____ Bottom _____ Total Depth of Well 4171 Feet
Show depth and thickness of all water, oil and gas formations.

OIL, GAS OR WATER RECORDS

CASING RECORD

FORMATION	CONTENT	FROM	TO	SIZE	PUT IN	PULLED OUT
				8 5/8"	275.46'	

Describe in detail the manner in which the well was plugged, indicating where the mud fluid was placed and the method or methods used in introducing it into the hole. If cement or other plugs were used, state the character of same and depth placed, from _____ feet to _____ feet for each plug set.

Gun up pits, forming heavy mud, pushed 1/4 sx hulls and wooden plug to 220', added 20 sx cement. Heavy mud to 35' pushed 1/4 sx hulls and wooden plug to 35', added 10 sx cement which formed a cap to top of surface casing.

RECEIVED
STATE CORPORATION COMMISSION

FEB 14 1963

CONSERVATION DIVISION
Wichita, Kansas

(If additional description is necessary, use BACK of this sheet)

Name of Plugging Contractor Garvey Drilling Company
Address RR #2 Great Bend, Kansas

STATE OF Kansas COUNTY OF Barton, ss.
Vern A. Morris (employee of owner) or (owner or operator) of the above-described

well, being first duly sworn on oath, says: That I have knowledge of the facts, statements, and matters herein contained and the log of the above-described well as filed and that the same are true and correct. So help me God.

(Signature) Vern A. Morris
RR #2 Great Bend, Kansas
(Address)

SUBSCRIBED AND SWORN TO before me this 12th day of February, 19 63

My commission expires October 24th, 1966

Notary Public.



WELL LOG

COMPANY TIME PETROLEUM COMPANY

SEC. 23 T. 25S R. 14W

FARM KIPP NO. 1

LOC. SW, SW, SW


TOTAL DEPTH 4171'

COUNTY STAFFORD CO., KANSAS

COMM. October 17, 1961 COMP. October 27, 1961

CONTRACTOR GARVEY DRILLING COMPANY

CASING 8-5/8" @ 283' w/250 sax.

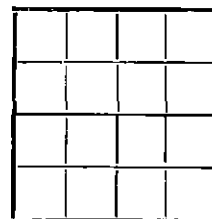

ELEVATION

PRODUCTION D & A

FIGURES INDICATE BOTTOM OF FORMATIONS

40	Surface sand
248	Shells & sand
283	Red bed
690	Red bed & shale
840	Red bed
870	Anhydrite
1450	Shale & shells
1800	Shale & lime
1938	Lime & shale
2290	Lime
2405	Lime & shale
2595	Shale & lime
3710	Lime & shale
4124	Lime
4171	Lime & conglomerate
4171	T. D.

RECEIVED
STATE CORPORATION COMMISSION

FEB 14 1963

CONSERVATION DIVISION
Wichita, Kansas

State of KANSAS
County of BARTON } ss

I, VERNE A. MORRIS of GARVEY DRILLING COMPANY

upon oath state the above and foregoing is a true and correct copy of the log of the #1 KIPP well.

Verne A. Morris

Subscribed and sworn to before me this 15th day of November 1961

My Commission Expires: November 12, 1962

Brandenburg
NOTARY PUBLIC