


STATE OF KANSAS
STATE CORPORATION COMMISSION

WELL PLUGGING RECORD

Give All Information Completely
Make Required Affidavit
Mail or Deliver Report to:
Conservation Division
State Corporation Commission
211 No. Broadway
Wichita, Kansas

NORTH

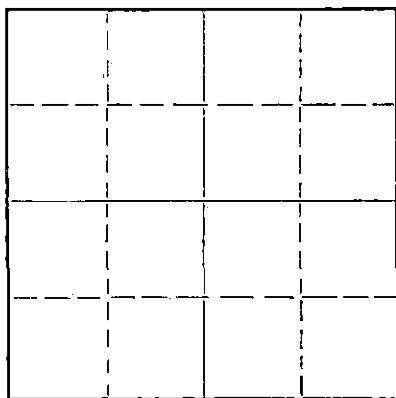

Locate well correctly on above
Section Flat

Stafford County. Sec. 23 Twp. 25S Rge. 14W(W)
Location as "NE/CNW/SW" or footage from lines 2310' fr. S, 1650' fr. W, SW/4
Lease Owner Phillips Petroleum Company
Lease Name Kipp Well No. 1
Office Address Box 779, Great Bend, Kansas
Character of Well (completed as Oil, Gas or Dry Hole) Dry Hole
Date well completed May 16 19 56
Application for plugging filed May 16 19 56
Application for plugging approved May 17 19 56
Plugging commenced May 16 19 56
Plugging completed May 16 19 56
Reason for abandonment of well or producing formation Dry Hole

If a producing well is abandoned, date of last production - 19 -
Was permission obtained from the Conservation Division or its agents before plugging was commenced? Yes

Name of Conservation Agent who supervised plugging of this well Mr. R. M. Brundage
Producing formation Dry Hole Depth to top - Bottom - Total Depth of Well 4032 Feet
Show depth and thickness of all water, oil and gas formations.

OIL, GAS OR WATER RECORDS

CASING RECORD

FORMATION	CONTENT	FROM	TO	SIZE	PUT IN	PULLED OUT
Heebner	Dry	3543	3561	9-5/8"	379.52 OA	None
Toronto	Dry	3561	3581			
Douglas	Dry	3581	3694			
Brown Limestone	Dry	3694	3724			
Lansing-Kansas City	Dry	3724	4019			

Describe in detail the manner in which the well was plugged, indicating where the mud fluid was placed and the method or methods used in introducing it into the hole. If cement or other plugs were used, state the character of same and depth placed, from _____ feet to _____ feet for each plug set.

Mudded hole 4032' to 330'. Pushed 1/3 sack Hulls to 330'. Set Howco plug at 330' and pumped in 35 sx. cement to 243'. Mudded hole to 35'. Pushed 1/3 sack hulls to 35'. Set Howco plug at 35' and filled to surface with 15 sx. cement. Well Plugged and Abandoned at 11:00 P.M. 5-16-56.

(If additional description is necessary, use BACK of this sheet)

Name of Plugging Contractor Phillips Petroleum Company
Address Oklahoma City, Oklahoma

STATE OF Kansas COUNTY OF Barton, ss.
A. J. Willis (employee of owner) ~~or true and correct~~ of the above-described

well, being first duly sworn on oath, says: That I have knowledge of the facts, statements, and matters herein contained and the log of the above-described well as filed and that the same are true and correct. So help me God.

(Signature) *A. J. Willis*
Box 779, Great Bend, Kansas
(Address)

SUBSCRIBED AND SWORN to before me this 18th day of May, 19 56

My commission expires November 18, 1957

Joseph P. [Signature]
STATE CORPORATION COMMISSION Notary Public.

PLUGGING
FILE SEC. 23 T. 25 R. 14W
BOOK PAGE 62 LINE 3

MAY 19 1956 5-19-56
CONSERVATION DIVISION
Wichita, Kansas

Phillips Petroleum Company **EXPLORATION RECORD**
 Kipp #1 - 2310' fr. S and 1650' fr. W. lines, SW/4 Sec. 23-25S-14W,
 Stafford County, Kansas - DRY HOLE

Lease Kipp

Well 1

Formation Name	Top	Base	Remarks
Clay and sand	0	335	
Sand and redbed	335	531	
Redbed, sand and anhydrite	531	880	
Salt and shale	880	1300	
Shale	1300	1600	
Lime and shale	1600	1824	
Lime	1824	2102	
Shale, sand and lime	2102	2257	
Lime and shale	2257	2381	
Shale	2381	2545	
Lime and shale	2545	3285	
Lime	3285	3566	
Lime and shale	3566	3753	
Lime	3753	4032	Drill Stem Tested
<u>FORMATION TOPS (Sample)</u>			
Hochner	3543		
Toronto	3561		
Douglas	3581		
Brown Limestone	3694		
Lansing-Kansas City	3724		
Base-Kansas City	4019		
Total Depth	4032		
Dry Hole - Well Plugged and abandoned 15-16-56.			See Daily Report Detailed

PLUGGING
 FILE SEC. 23 T. 25 R. 14W
 BOOK PAGE 62 LINE 3

RECEIVED
 STATE CORPORATION COMMISSION
 MAY 19 1956
 CONSERVATION DIVISION
 Wichita, Kansas