

STATE OF KANSAS
STATE CORPORATION COMMISSION

WELL PLUGGING RECORD

Give All Information Completely
Make Required Affidavit
Mail or Deliver Report to:
Conservation Division
State Corporation Commission
800 Bittling Building
Wichita, Kansas

Stafford County, Sec. 23 Twp. 25 Rge. 14 (#) (W)

Location as "NE/CNW/SW" or footage from lines SW NE NW

Lease Owner Deep Rock Oil Corporation

Lease Name Tanner Well No. 2

Office Address Box 1051, Tulsa 2, Oklahoma

Character of Well (completed as Oil, Gas or Dry Hole) Dry Hole

Date well completed November 13 19 54

Application for plugging filed November 12 19 54

Application for plugging approved 19


Plugging commenced November 13, 19 54

Plugging completed November 13, 19 54

Reason for abandonment of well or producing formation Dry

If a producing well is abandoned, date of last production 19

Was permission obtained from the Conservation Division or its agents before plugging was commenced? Verbal

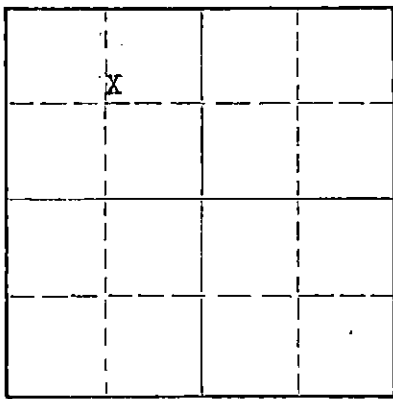

Locate well correctly on above Section Plat

Name of Conservation Agent who supervised plugging of this well

Producing formation none Depth to top Bottom Total Depth of Well 3910 Feet

Show depth and thickness of all water, oil and gas formations.

OIL, GAS OR WATER RECORDS

CASING RECORD

FORMATION	CONTENT	FROM	TO	SIZE	PUT IN	PULLED OUT
Surface sands	Water to 90'	0	290			
Red beds	0	290	307	10 3/4	307	None
Sand, lime, shale	Salt Water	307	3910		None	None

Describe in detail the manner in which the well was plugged, indicating where the mud fluid was placed and the method or methods used in introducing it into the hole. If cement or other plugs were used, state the character of same and depth placed, from feet to feet for each plug set.

Circulated heavy mud (about 12#/gal.) from T.D. to surface.
20 sax cement plug with 1/3 sack hulls placed thru drill pipe with tap @ 290'.
Filled hole back to 35' with heavy mud.
10 sax cement plug with 1/3 sack hulls, placed thru drill pipe from 35' back to surface.

(If additional description is necessary, use BACK of this sheet)

Name of Plugging Contractor Gabbert & Jones

Address 514 Orpheum Building, Wichita, Kansas

STATE OF Oklahoma, COUNTY OF Texas, ss.

D. K. Auld (employee of owner) or (owner or operator) of the above-described well, being first duly sworn on oath, says: That I have knowledge of the facts, statements, and matters herein contained and the log of the above-described well as filed and that the same are true and correct. So help me God.


(Signature) [Signature]

Box 395, Tyrone, Oklahoma
(Address)

SUBSCRIBED AND SWORN TO before me this 30th day of November, 1954

[Signature]
Notary Public.

My commission expires 5-24-56

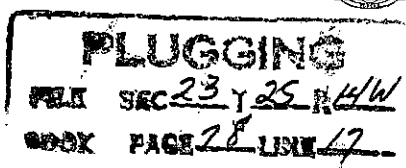

12-2-54

GABBERT-JONES DRILLING COMPANY
WICHITA, KANSAS
DRILLER'S WELL LOG

TANNER #2
 SW NE NW, SEC. 23-25-14W
 STAFFORD COUNTY, KANSAS
 COMMENCED 11-2-54
 COMPLETED 11-13-54

DEPTH		FORMATION	REMARKS
FROM	TO		
0	230	SURFACE CLAY & SAND	
230	296	RED BED	RAN 307' OF 10 3/4" CASING CEMENTED @ 296' w/250 BAGGS CEMENT.
296	850	RED BED	
850	895	ANHYDRITE	
895	950	SHALE & SHELLS	
950	1340	SHALE	
1340	1845	SHALE & SHELLS	
1845	2115	LIME & SHALE	
2115	2250	LIME	
2250	2925	LIME & SHALE	
2925	3050	SHALE & SHELLS	
3050	3460	LIME & SHALE	
3460	3631	LIME	
3631	3660	SHALE	
3660	3700	SAND	
3700	3910	LIME	
3910	TD		DRY AND ABANDONED

EXECUTED THIS 23RD DAY OF NOVEMBER, 1954

C. L. Gabbert

STATE OF KANSAS }
 COUNTY OF SEDGWICK) SS

BEFORE ME, THE UNDERSIGNED, A NOTARY PUBLIC, WITHIN AND FOR SAID COUNTY AND STATE, ON THIS 24 DAY OF November, 1954, PERSONALLY APPEARED C. L. Gabbert TO ME PERSONALLY KNOWN TO BE THE IDENTICAL PERSON WHO EXECUTED THE WITHIN AND FOREGOING INSTRUMENT AND ACKNOWLEDGED TO ME THAT HE EXECUTED THE SAME AS HIS FREE AND VOLUNTARY ACT AND DEED FOR THE USES AND PURPOSES THEREIN SET FORTH.

IN WITNESS WHEREOF, I HAVE HEREUNTO SET MY HAND AND OFFICIAL SEAL THE DAY AND YEAR LAST ABOVE WRITTEN.

MY COMMISSION EXPIRES 11-15-58

Samuel S. Hall
 NOTARY PUBLIC

PLUGGING
 SEC 23-25-14W
 BOX PAGE 28 LINE 17