


STATE OF KANSAS
STATE CORPORATION COMMISSION

WELL PLUGGING RECORD

Give All Information Completely
Make Required Affidavit
Mail or Deliver Report to:
Conservation Division
State Corporation Commission
212 North Market, Insurance Bldg.
Wichita, Kansas

Pratt County, Sec. 11 Twp. 29S Rge. (E) 14 (W)
Location as "NE/CNW/SW" or footage from lines C-NW-NW-NE
Lease Owner Amerada Petroleum Corporation
Lease Name Robert Lee Well No. 1
Office Address Box 197, Great Bend, Kansas
Character of Well (completed as Oil, Gas or Dry Hole) Dry Hole.
Date well completed 6-19- 19 61
Application for plugging filed 6-19- 19 61
Application for plugging approved 6-19- 19 61
Plugging commenced 10:15 PM 6-19- 19 61
Plugging completed 1:00 AM 6-20- 19 61
Reason for abandonment of well or producing formation Dry Hole

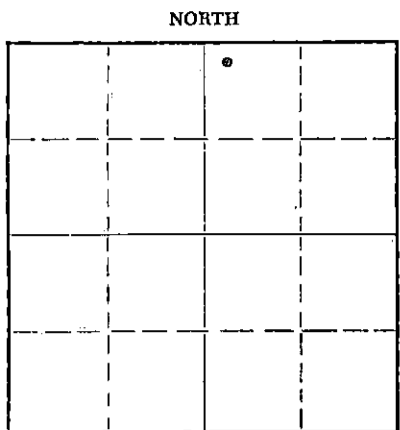

Locate well correctly on above Section Plat

If a producing well is abandoned, date of last production - 19 -
Was permission obtained from the Conservation Division or its agents before plugging was commenced? Yes

Name of Conservation Agent who supervised plugging of this well Frank Broadfoot
Producing formation - Depth to top - Bottom - Total Depth of Well 4690 Feet
Show depth and thickness of all water, oil and gas formations.

OIL, GAS OR WATER RECORDS

CASING RECORD

FORMATION	CONTENT	FROM	TO	SIZE	PUT IN	PULLED OUT
				8-5/8"	368'	None

Describe in detail the manner in which the well was plugged, indicating where the mud fluid was placed and the method or methods used in introducing it into the hole. If cement or other plugs were used, state the character of same and depth placed, from - feet to - feet for each plug set.

Filled hole with heavy mud from 4690' to 340'.
Spotted Cement Plug from 340' to 279' with 20 Sacks Cement.
Filled hole with heavy mud from 279' to 35'.
Spotted Cement plug from 35' to top with 10 Sacks Cement.

RECEIVED
STATE CORPORATION COMMISSION
JUN 26 1961
CONSERVATION DIVISION
Wichita, Kansas

(If additional description is necessary, use BACK of this sheet)

Name of Plugging Contractor Barbour Drilling Company
Address P.O. Box 3806, Tulsa, Oklahoma

STATE OF Kansas, COUNTY OF -, ss.
C.E. Richardson (employee of owner) ~~operator~~ of the above-described well, being first duly sworn on oath, says: That I have knowledge of the facts, statements, and matters herein contained and the log of the above-described well as filed and that the same are true and correct. So help me God.

(Signature) C.E. Richardson
Box 197, Great Bend, Kansas
(Address)

SUBSCRIBED AND SWORN TO before me this 22nd day of June, 19 61.

Charles H. Tolson
Notary Public.

My commission expires November 21, 1961

AMERADA PETROLEUM CORPORATION
 BOX 197
 GREAT BEND, KANSAS

Robert Lee No. 1
 C NW-NW-NE
 Section 11-29S-14W
 Pratt County, Kansas

DRILLER'S LOG:

<u>FROM</u>	<u>TO</u>	<u>FORMATION</u>
0'	125'	Clay & Sand
125'	225'	Sand
225'	810'	Red Bed & Shale
810'	830'	Anhydrite
830'	1040'	Shale & Shells
1040'	1945'	Shale
1945'	2025'	Shale & Lime
2025'	2280'	Lime
2280'	2390'	Lime & Shale
2390'	2595'	Lime
2595'	2705'	Lime & Shale
2705'	2820'	Lime
2820'	3033'	Lime & Shale
3033'	3150'	Shale
3150'	3250'	Shale & Lime
3250'	3550'	Lime
3550'	3630'	Lime & Shale
3630'	3745'	Lime
3745'	3895'	Lime & Shale
3895'	3942'	Shale & Lime
3942'	4020'	Sand, Shale & Lime
4020'	4371'	Lime
4371'	4390'	Shale & Lime
4390'	4470'	Lime
4470'	4500'	Lime & Chert
4500'	4528'	Lime
4528'	4578'	Lime & Chert
4578'	4584'	Sand
4584'	4631'	Sand & Shale
4631'	4672'	Shale
4672'	4690'	Dolomite

Surface Casing: 8-5/8" 24# Set @ 368'.
 Plugged & Abandoned. Dry Hole.

RECEIVED
 STATE CORPORATION COMMISSION

JUN 26 1961

CONSERVATION DIVISION
 Wichita, Kansas