


STATE OF KANSAS  
STATE CORPORATION COMMISSION  
CONSERVATION DIVISION  
P. O. BOX 17027  
WICHITA, KANSAS 67217

FORM CP-4

### WELL PLUGGING RECORD

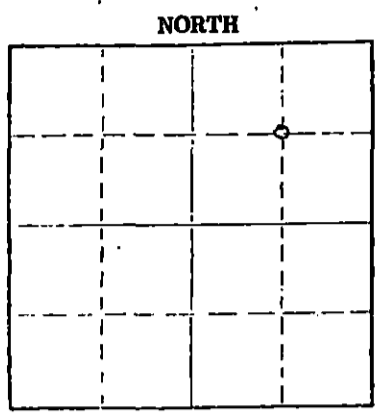

Locate well correctly on above Section Plat

Pratt County, Sec. 10 Twp. 29 Rgs. (E) 14 (W)  
 Location as "NE/CNWxSWx" or footage from lines C NE/4  
 Lease Owner Derrick-American Oil, Inc.  
 Lease Name Bryan Well No. 1  
 Office Address 507 Insurance Bldg Wichita, Kansas 67202  
 Character of Well (completed as Oil, Gas or Dry Hole) Dry Hole  
 Date well completed 10/19/75 19  
 Application for plugging filed 10/19/75 19  
 Application for plugging approved 10/19/75 19  
 Plugging commenced 10/19/75 19  
 Plugging completed 10/19/75 19  
 Reason for abandonment of well or producing formation D & A

If a producing well is abandoned, date of last production 19  
 Was permission obtained from the Conservation Division or its agents before plugging was commenced? Yes

Name of Conservation Agent who supervised plugging of this well Russel Biberstine  
 Producing formation \_\_\_\_\_ Depth to top \_\_\_\_\_ Bottom \_\_\_\_\_ Total Depth of Well 3167 Feet  
 Show depth and thickness of all water, oil and gas formations.

OIL, GAS OR WATER RECORDS				CASING RECORD		
FORMATION	CONTENT	FROM	TO	SIZE	PUT IN	PULLED OUT
				8 3/8"	350'	- 0 -

Describe in detail the manner in which the well was plugged, indicating where the mud fluid was placed and the method or methods used in introducing it into the hole. If cement or other plugs were used, state the character of same and depth placed, from \_\_\_\_\_ feet to \_\_\_\_\_ feet for each plug set.

Plug at 300' with 35 sx.  
 " " 40' " 15 sx.  
 Bridge patch " 2 sx.

(If additional description is necessary, use BACK of this sheet)  
 Name of Plugging Contractor Gabbert-Jones Drilling, Inc.  
 Address Sutton Place, Wichita, Kansas

STATE OF Kansas COUNTY OF Sedgewick, ss.

(employee of owner) or (owner or operator) of the above-described well, being first duly sworn on oath, says: That I have knowledge of the facts, statements, and matters herein contained and the log of the above-described well as filed and that the same are true and correct. So help me God.

(Signature) *John W. Thompson*

Subscribed and sworn to before me this 2nd day of July, 1976

(Address) *Elizabeth J. Edwards*  
 Notary Public.

My commission expires 5-6-79



RECEIVED  
 STATE CORPORATION COMMISSION  
 07-06-76  
 WICHITA, KANSAS

GABBERT-JONES, INC.  
 WICHITA, KANSAS  
 DRILLERS' WELL LOG

BRYAN #1  
 C NE/4, Section 10-29S-14W  
 Pratt County, Kansas

Commenced: October 13, 1975  
 Completed: October 19, 1975

OPERATOR: DEPRICK AMERICAN

Depth From	Depth To	Formation	Remarks
0	65	Surface clay	Ran 8 jts of used 28# 8 5/8" csg. set @ 350' cemented w/ 350 sks common 3% CC P.D. 3:00 PM 10/13/1975
65	235	Sand	
235	356	Redbed	
356	1260	Shale - shells	
1260	2030	Shale - lime	
2030	3000	Lime - shale	
3000	3015	Lime	
3015	3067	Lime - shale	
3067	3150	Lime	
3150		FD	

I, James S. Sutton II, certify this is a correct copy of the Drillers' Log for the well drilled in the C NE/4 of Section 10-29S-14W, Pratt County, Kansas to the best of my knowledge and belief.

*James S. Sutton II*  
 James S. Sutton, II


STATE OF KANSAS        )  
                               ) SS  
 COUNTY OF SEDGWICK    )

Before me, the undersigned, a Notary Public within and for said County and State, on this 31st day of October, 1975, personally appeared James S. Sutton II to me personally known to be the identical person who executed the within and foregoing instrument and acknowledged to me that he executed the same as his free and voluntary act and deed for the uses and purposes therein set forth.

IN WITNESS WHEREOF, I have hereunto set my hand and official seal the day and year last above written.

*Elizabeth J. Edwards*  
 Elizabeth J. Edwards

My Commission expires February 6, 1979

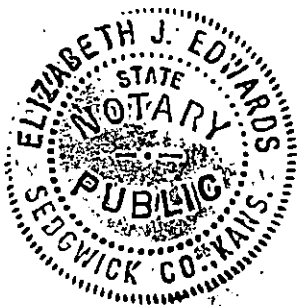

RECEIVED  
 STATE OF KANSAS COMMISSION

OCT 06 1975

CONCEIVED BY STATE  
 WICHITA, Kansas