


STATE OF KANSAS
STATE CORPORATION COMMISSION
CONSERVATION DIVISION
P. O. BOX 17027
WICHITA, KANSAS 67217

WELL PLUGGING RECORD

Pratt County. Sec. 10 Twp 29 Rge. (E) 14 (W)
Location as "NE/CNW/SW" or footage from lines Approx C SW/4
Lease Owner Derrick American Oil, Inc.
Lease Name Moss Well No. 1
Office Address 507 Insurance Bldg, Wichita Kansas 67202
Character of Well (completed as Oil, Gas or Dry Hole) Dry Hole
Date well completed 6/16/76 19
Application for plugging filed 6/16/76 19
Application for plugging approved 6/16/76 19
Plugging commenced 6/16/76 19
Plugging completed 12:30 AM 6/16/76 19
Reason for abandonment of well or producing formation D & A

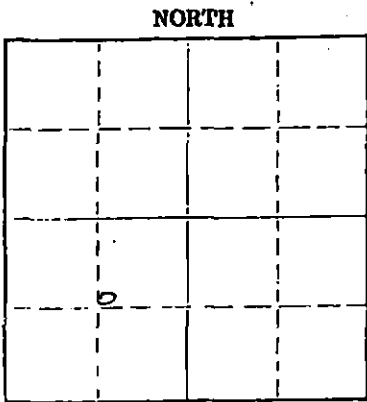

Locate well correctly on above Section Plat

If a producing well is abandoned, date of last production _____ 19____
Was permission obtained from the Conservation Division or its agents before plugging was commenced? Yes

Name of Conservation Agent who supervised plugging of this well Russel Biberstine
Producing formation _____ Depth to top _____ Bottom _____ Total Depth of Well 4672 Feet
Show depth and thickness of all water, oil and gas formations.

OIL, GAS OR WATER RECORDS

CASING RECORD

FORMATION	CONTENT	FROM	TO	SIZE	PUT IN	PULLED OUT
				8 5/8"	368'	- 0 -

Describe in detail the manner in which the well was plugged, indicating where the mud fluid was placed and the method or methods used in introducing it into the hole. If cement or other plugs were used, state the character of same and depth placed, from _____ feet to _____ feet for each plug set.

Plug at 350' with 35 sx.
Plug at 40' " 15 sx.
Bridge rathole with 2 sx.

(If additional description is necessary, use BACK of this sheet)

Name of Plugging Contractor Gabbert & Jones Drilling, Inc.
Address Sutton Place, Wichita, Kansas


STATE OF Kansas COUNTY OF Sedgewick ss.

_____, (employee of owner) or (owner or operator) of the above-described well, being first duly sworn on oath, says: That I have knowledge of the facts, statements, and matters herein contained and the log of the above-described well as filed and that the same are true and correct. So help me God.

(Signature) [Signature]
(Address) _____

SUBSCRIBED AND SWORN TO before me this 2nd day of July, 1976

My commission expires 2-6-79
Elizabeth J. Edwards Notary Public.

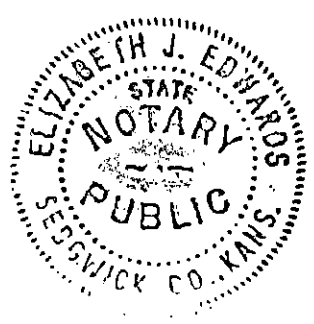

RECORDED
CONSERVATION COMMISSION
JUL 06 1976
07-06-76
CONSERVATION DIVISION
Wichita, Kansas

GABBERT-JONES, INC.
 WICHITA, KANSAS
 DRILLER' WELL LOG

Moss #1
 C-SW/4 Sec 10-29S-14W
 Pratt County, Kansas

Commenced: 6-2-76

Completed: 6-16-76

OPERATOR: DERRICK-AMERICAN OIL, INC.

Depth		Formation	Remarks
From	to		
0	100	Surface Clay-Sand	Ran 9 jts of used 28# 8 5/8" csg set @ 368' Cemented w/400 lbs Common 3Z CC PD @ 1:45 p.m. 6-3-76
100	260	Sand	
260	375	Redbed-Shale	
375	870	Shale-Shells	
870	1195	Shale-Sand	
1195	2005	Shale-Shells	
2005	2115	Shale	
2115	2495	Shale-Lime	
2495	3815	Lime-Shale	
3815	4672	Lime	
	4672 - TD		DRY & ABANDONED

STATE OF KANSAS)
) SS
 COUNTY OF SEDGWICK)

I, the undersigned, being duly sworn on oath, state that the above Drillers Log is true and correct to the best of my knowledge and belief and according to the records of this office.

GABBERT-JONES, INC.

James S. Sutton
 JAMES S. SUTTON II

Suscribed and sworn to before me this 18th day of June, 1976.

Elizabeth J. Edwards
 ELIZABETH J. EDWARDS

My Commission expires February 6, 1976.

