

15.151-10042-00-02

STATE OF KANSAS
STATE CORPORATION COMMISSION

WELL PLUGGING RECORD

Give All Information Completely
Make Required Affidavit
Mail or Deliver Report to:
Conservation Division
State Corporation Commission
211 No. Broadway
Wichita, Kansas

Pratt

County. Sec. 24 Twp. 29 Rge. 14 (#) W (W)

Location as "NE/CNW&SW" or footage from lines SE SW SE

Lease Owner Monsanto Chemical Company

Lease Name Andrews "A" Well No. 2

Office Address Box 580, Pratt, Kansas

Character of Well (completed as Oil, Gas or Dry Hole) Oil

Date well completed 7-12 19 44

Application for plugging filed 8-31 19 60

Application for plugging approved 9-5 19 60


Plugging commenced 9-19 19 60

Plugging completed 9-22 19 60

Reason for abandonment of well or producing formation Depleted

If a producing well is abandoned, date of last production April 19 49

Was permission obtained from the Conservation Division or its agents before plugging was commenced? Yes

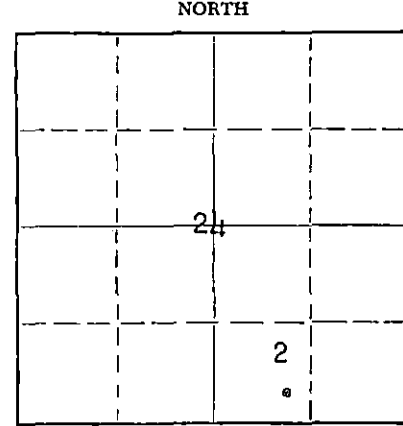

Locate well correctly on above Section Plat

Name of Conservation Agent who supervised plugging of this well Fred Hampel

Producing formation Simpson Depth to top 4343 Bottom 4360 Total Depth of Well 4440 Feet

Show depth and thickness of all water, oil and gas formations.

OIL, GAS OR WATER RECORDS

CASING RECORD

FORMATION	CONTENT	FROM	TO	SIZE	PUT IN	PULLED OUT
				8-5/8"	491'	None
				5-1/2"	4415'	2332'

Describe in detail the manner in which the well was plugged, indicating where the mud fluid was placed and the method or methods used in introducing it into the hole. If cement or other plugs were used, state the character of same and depth placed, from _____ feet to _____ feet for each plug set.

Checked hole to 4440' and found it clear.
Ran sand from 4440' to 4400' and dumped 4 sacks
of cement @ 440' with dump bailer. Pulled
5 1/2" casing. Mudded hole to 300', set 10'
rock bridge to 290' and ran 20 sacks of
cement. Mudded to 35', set 5' rockbridge
to 30' and ran 10 sacks of cement to base
of cellar.

PLUGGING COMPLETED.

RECEIVED
STATE CORP. COMMISSION
SEP 28 1960
CONSERVATION DIVISION
Wichita, Kansas
09-28-60

Name of Plugging Contractor Knight Casing Pulling Co.
Address Chase, Kansas

STATE OF Kansas, COUNTY OF Pratt, ss.
Bruce E. Roll (employee of owner) or (~~owner or operator~~) of the above-described well, being first duly sworn on oath, says: That I have knowledge of the facts, statements, and matters herein contained and the log of the above-described well as filed and that the same are true and correct. So help me God.

(Signature) Bruce E. Roll
P. O. Box 580, Pratt, Kansas
(Address)

SUBSCRIBED AND SWORN TO before me this 26th day of September 19 60

My commission expires September 4, 1962

Van Hauvek
Notary Public.



WELL LOG BUREAU--KANSAS GEOLOGICAL SOCIETY
412 Union National Bk. Bldg., Wichita, Kansas


COPY

Company - LION OIL REFG. CO.
Farm - Andrews No. 2.

SEC. 24 T. 29 R. 14 W
SE SW SE

Total Depth. 4440'
Comm. 4-21-44 Comp. 6-20-44
Shot or Treated.
Contractor. R.W. Rine Drlg. Co.
Issued. 8-19-44

County. Pratt
KANSAS

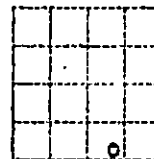

CASING:
8 5/8" 505' Cem.
8 1/2" 4420' Cem. *2000*

Elevation. _____

Production. Est. 35 B.

Figures Indicate Bottom of Formations.

clay	0-30
sand & gravel	225
red rock	305
red rock & gravel	495
shells & shale	1890
lime	2320
lime & shale	2335
shale	2380
lime	2405
shale & lime	2492
lime	2536
lime & shale	3075
lime	3231
shale & lime	3365
lime	3635
shale & lime	3773
lime	3810
shale & lime	3841
shale	3903
lime	4380
shale & lime	4405
shale	4418
lime	4440
Total Depth	

Tops:
Lansing 3922
Simpson 4343 (corr)
Arbuckle 4411 (corr)

RECEIVED
STATE CORPORATION COMMISSION

OCT 5 1960

CONSERVATION DIVISION
Wichita, Kansas