

STATE OF KANSAS  
STATE CORPORATION COMMISSION

WELL PLUGGING RECORD

Give All Information Completely  
Make Required Affidavit  
Mail or Deliver Report to:  
Conservation Division  
State Corporation Commission  
211 No. Broadway  
Wichita, Kansas

Pratt County. Sec. 24 Twp. 29S Rge. 14E 14 (W)

Location as "NE/CNW/SW" or footage from lines SE/4 SE/4 SE/4

Lease Owner Monsanto Chemical Company

Lease Name Andrews "A" Well No. 1

Office Address P. O. Box 580, Pratt, Kansas

Character of Well (completed as Oil, Gas or Dry Hole) Oil

Date well completed 4-25 19 60

Application for plugging filed 8-31 19 60

Application for plugging approved 9-5 19 60


Plugging commenced 9-7 19 60

Plugging completed 9-10 19 60

Reason for abandonment of well or producing formation Depleted

If a producing well is abandoned, date of last production September 19 58

Was permission obtained from the Conservation Division or its agents before plugging was commenced? Yes

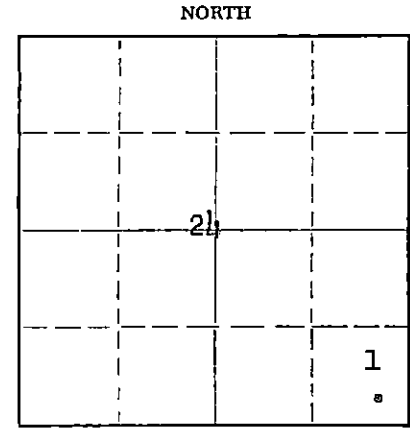

Locate well correctly on above Section Plat

Name of Conservation Agent who supervised plugging of this well Fred Hampel

Producing formation Simpson Depth to top 4395 Bottom 4430 Total Depth of Well 4518 Feet

Show depth and thickness of all water, oil and gas formations.

OIL, GAS OR WATER RECORDS

CASING RECORD

FORMATION	CONTENT	FROM	TO	SIZE	PUT IN	PULLED OUT
				8-5/8"	491'	None
				5-1/2"	4472'	2715'

Describe in detail the manner in which the well was plugged, indicating where the mud fluid was placed and the method or methods used in introducing it into the hole. If cement or other plugs were used, state the character of same and depth placed, from \_\_\_\_\_ feet to \_\_\_\_\_ feet for each plug set.

Checked hole to 4431'. Ran sand to 4340' and dumped 4 sacks of cement at 4340' with dump bailer. Pulled 5-1/2" casing. Mudded hole to 310', set 10' rock bridge to 300' and ran 20 sacks of cement at 300'. Mudded hole to 40'. Set rock bridge from 40' to 30' and ran 10 sacks of cement to base of cellar. Plugging completed.

SEP 15 1960 09-16-60

CONSERVATION DIVISION  
Wichita, Kansas

Name of Plugging Contractor Knight Casing Pulling Company  
Address Chase, Kansas

STATE OF KANSAS, COUNTY OF PRATT, ss. Bruce E. Roll (employee of owner) of the above-described

well, being first duly sworn on oath, says: That I have knowledge of the facts, statements, and matters herein contained and the log of the above-described well as filed and that the same are true and correct. So help me God.

(Signature) Bruce E. Roll

P. O. Box 580, Pratt, Kansas (Address)

SUBSCRIBED AND SWORN TO before me this 15th day of September, 19 60.

Dan Houbek (Signature)

My commission expires September 4, 1962

Notary Public.



Lion Oil Refining Company  
El Dorado, Arkansas

Andrews Well No. 1

S/2, SE/4  
Sec. 24-29S-14W  
Pratt County, Kansas

Contractor: R. W. Rine Drilling Company  
Commenced: March 11, 1944

Completed: April 23, 1944

	LOG	
Clay	0-40	
Sand & Gravel	40-230	
Red Bed	230-440	
Gravel	440-490	
Shells	490-527	8 5/8" casing cemented @ 514'
Red Bed & Shells	527-775	
Shale & Sand	775-1375	
Shale & Shells	1375-1930	
Lime	1930-2300	
Lime & Shale	2300-2375	
Lime	2375-2425	
Shale	2425-2450	
Lime	2450-2650	
Shale & Lime	2650-2945	
Shale	2945-3055	
Shale & Lime	3055-3445	
Lime	3445-3715	
Lime & Shale	3715-3813	
Sand	3813-3829	
Sand & Shale	3829-3897	
Shale & Lime	3897-3955	
Lime	3955-4048	
Lime & Shale	4048-4080	
Lime	4080-4120	
Lime & Chert	4120-4122	
Lime	4122-4340	
Lime & Chert	4340-4361	
Lime, Shale & Chert	4361-4394	
Shale & Lime	4394-4410	
Sand & Shale	4410-4440	
Shale	4440-4480	5 1/2" Casing cemented at 4472'
Lime	4480-4484	
Lime & Shale	4484-4488	Total Depth 4488'

State of Kansas) ss.  
County of Barton}

I, Clyde W. Goddard, do hereby certify that the above is a true and complete log of the Andrews Well No. 1, located in the S/2 of the SE/4 of Section 24, Township 29S, Range 14 West Pratt County, Kansas.

*Clyde W. Goddard*

Sworn to and subscribed before me this 25th day of April, 1944.

*Marian L. Raymond*

My commission expires March 27, 1948

