


STATE OF KANSAS
STATE CORPORATION COMMISSION

Give All Information Completely
Make Required Affidavit
Mail or Deliver Report to:
Conservation Division
State Corporation Commission
212 North Market, Insurance Bldg.
Wichita, Kansas

WELL PLUGGING RECORD

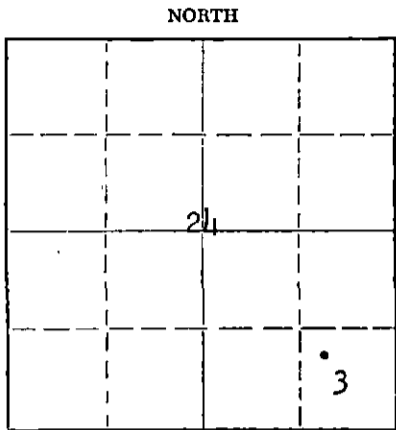

Locate well correctly on above
Section Plat

Pratt County. Sec. 24 Twp. 29 Rge. 14 (E)/ W. (W)
Location as "NE/CNW/SW" or footage from lines NW SE SE
Lease Owner Monsanto Chemical Company
Lease Name Andrews "A" Well No. 3
Office Address Box 580, Pratt, Kansas
Character of Well (completed as Oil, Gas or Dry Hole) Oil
Date well completed 11-4 19 45
Application for plugging filed 8-31 19 60
Application for plugging approved 9-5 19 60
Plugging commenced 9-12 19 60
Plugging completed 9-17 19 60
Reason for abandonment of well or producing formation Depleted

If a producing well is abandoned, date of last production April 19 57
Was permission obtained from the Conservation Division or its agents before plugging was commenced? Yes

Name of Conservation Agent who supervised plugging of this well Fred Hampel
Producing formation Arbuckle Depth to top 4304 Bottom 4360 Total Depth of Well 4435 Feet
Show depth and thickness of all water, oil and gas formations.

OIL, GAS OR WATER RECORDS

CASING RECORD

FORMATION	CONTENT	FROM	TO	SIZE	PUT IN	PULLED OUT
				9"	478'	None
				5-1/2"	4434'	2929'

Describe in detail the manner in which the well was plugged, indicating where the mud fluid was placed and the method or methods used in introducing it into the hole. If cement or other plugs were used, state the character of same and depth placed, from _____ feet to _____ feet for each plug set.

Checked hole to 4360' and found it clear.
Ran sand to 4310' and dumped 4 sacks of cement @ 4310' with dump bailer. Pulled 2 jts. of 5 1/2" casing. Pumped in 40 sacks of jell mud and 20 sacks of weight mud. Pulled balance of 5 1/2" casing. Mudded hole to 300', set 10' rock bridge to 290' and ran 25 sacks of cement. Mudded to 40'. Set 10' rock bridge to 30' and ran 15 sacks of cement to base of cellar.

PLUGGING COMPLETED.

RECEIVED
STATE CORPORATION COMMISSION
9-28-60
SEP 28 1960
CONSERVATION DIVISION
Wichita, Kansas

(If additional description is necessary, use BACK of this sheet)
Name of Plugging Contractor Knight Casing Pulling Co.
Address Chase, Kansas

STATE OF Kansas COUNTY OF Pratt, ss.
Bruce E. Roll (employee of owner) or (~~owner~~) of the above-described well, being first duly sworn on oath, says: That I have knowledge of the facts, statements, and matters herein contained and the log of the above-described well as filed and that the same are true and correct. So help me God.

(Signature) Bruce E. Roll
P. O. Box 580, Pratt, Kansas
(Address)

SUBSCRIBED AND SWORN TO before me this 26th day of September, 19 60

Van Laubek
Notary Public.

My commission expires September 4, 1962

PARKER DRILLING COMPANY

ANDREWS #3

NW CORNER SE/4 SE/4 Sec. 24-T-29S-R-14 W.
PRATT COUNTY- KANSAS

<u>FORMATION</u>	<u>FROM</u>	<u>TO</u>
Clay and sand	0	70
Clay and sand	70	130
Sand	180	180
Sand and shale	180	210
Shale	210	275
Red bed	275	680
Anhydrite	680	710
Shale	710	870
Sand and shale	870	1135
Shale	1135	1260
Shale & brkn. lime	1260	1500
Shale & salt	1500	1550
Shale & brkn. lime	1550	1630
Shale & shells	1630	1910
Lime	1910	2585
Shale	2585	2588
Lime	2588	2685
Lime & shale	2685	2790
Shale & shells	2790	3055
Lime	3055	3120
Shale & shells	3120	3155
Shale & lime	3155	3255
Shale	3255	3260
Shale & shells	3260	3290
Lime & shale	3290	3380
Shale	3380	3395
Lime & shale	3395	3425
Shale & lime shells	3425	3490
Lime	3490	3690
Shale & lime shells	3690	3800
Lime	3800	3966
Cherty lime	3966	3978
Lime	3978	4018
Lime cherty	4018	4035
Lime	4035	4276
Cherty lime	4276	4294
Lime	4294	4296
Chert	4296	4298
Lime	4298	4299
Chert & lime	4299	4302
Chert, lime & shale	4302	4310
Lime	4310	4317
Chert	4317	4319
Lime	4319	4320
Chert	4320	4321
Lime	4321	4324
Chert	4324	4325
Lime	4325	4334
Shale & Lime shells	4334	4370
Lime	4370	4335