

STATE OF KANSAS
STATE CORPORATION COMMISSION


WELL PLUGGING RECORD

OR
FORMATION PLUGGING RECORD

Give All Information Completely
Make Required Affidavit
Mail or Deliver Report to:
Conservation Division
State Corporation Commission
800 Bitting Building
Wichita, Kansas

Strike out upper line
when reporting plug-
ging off formations.
SE 1/4 SW 1/4

NORTH

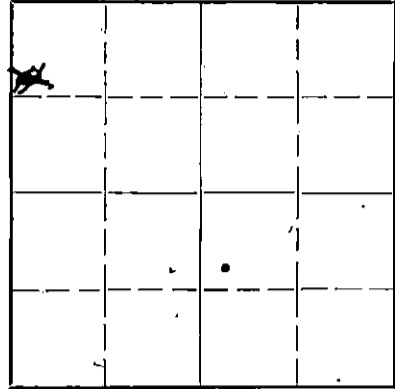

Locate well correctly on above
Section Plat

Pratt County, Sec. 24 Twp. 29 Rge. 14 (E) (W)
Location as "NE 1/4 NW 1/4 SW 1/4" or footage from lines SE cor. 11/2 SW 1/4
Lease Owner Lion Oil Refining Co.
Lease Name Chastain
Office Address El Dorado, Ark.
Well No. 1
Character of Well (completed as Oil, Gas or Dry Hole) Dry Hole
Date well completed 6-19 19 44.
Application for plugging filed 6-20 19 44.
Application for plugging approved 6-20 19 44.
Plugging commenced 6-20 19 44.
Plugging completed 6-21 19 44.
Reason for abandonment of well or producing formation Dry Hole

If a producing well is abandoned, date of last production 19
Was permission obtained from the Conservation Division or its agents before plugging was com-
menced? Yes

Name of Conservation Agent who supervised plugging of this well Eldon Petty
Producing formation Depth to top Bottom Total Depth of Well 4637 Feet
Show depth and thickness of all water, oil and gas formations.

OIL, GAS OR WATER RECORDS

CASING RECORD

Formation	Content	From	To	Size	Put In	Pulled Out

Describe in detail the manner in which the well was plugged, indicating where the mud fluid was placed and the method or methods used in introducing it into the hold. If cement or other plugs were used, state the character of same and depth placed, from feet to feet for each plug set.

Heavy mud pumped in up to 505'. Bridging Plug sets at 450' using 15 sacks. Bridging Plug set at 30' using 10 sacks cement.

PLUGGING
FILE SEC 24 29 R 14 W
BOOK PAGE 21 LINE 32

(If additional description is necessary, use BACK of this sheet)

Correspondence regarding this well should be addressed to Lion Oil Refining Co.
Address El Dorado, Arkansas.

STATE OF _____, COUNTY OF _____, ss.

_____ (employee of owner) or (owner or operator) of the above-described well,
being first duly sworn on oath, says: That I have knowledge of the facts, statements, and matters herein contained and the log of the above-described well as filed and that the same are true and correct. So help me God.

(Signature) Thomas Hayes

(Address)

SUBSCRIBED AND SWORN to before me this 23 day of June 19 44
Ruth Reukerliwch
Notary Public.

My commission expires Nov. 4, 1947

06-24-44

Lion Oil Refining Company
El Dorado, Arkansas

Chastain Well No. 1

SE Corner of the N/2, SW/4
Sec. 24-29S-14W
Pratt County, Kansas

Contractor: R. W. Rine Drilling Company
Commenced: May 25, 1944

Completed: June 20, 1944

	LOG	
Sand	0-192	
Red Shale	192-505	8 5/8" Casing cemented @ 505'
Red Bed & Shale	505-915	
Shale	915-1405	
Shale & Shells	1405-1920	
Lime	1920-2055	
Shale & Lime	2055-2305	
Shale & Shells	2305-2375	
Lime & Shale	2375-2455	
Lime	2455-2515	
Shale & Lime	2515-2900	
Shale	2900-3035	
Shale & Lime	3035-3135	
Lime	3135-3170	
Lime & Shale	3170-3480	
Lime	3480-3844	
Lime & Shale	3844-3950	
Lime	3950-4043	
Lime & Shale	4043-4114	
Lime	4114-4384	
Lime & Chert	4384-4425	
Lime	4425-4463	
Lime & Chert	4463-4535	
Lime	4535-4544	
Sand & Shale	4544-4553	
Shale	4553-4560	
Sand & Shale	4560-4624	
Lime	4624-4637	Total Depth 4637'

State of Kansas)
County of Barton) ss.

I, Clyde W. Goddard, do hereby certify that the above is a true and complete log of the Chastain Well No. 1, located in the SE Corner of the N/2 of the SW/4 of Section 24, Township 29S, Range 14 West, Pratt County, Kansas.

PLUGGING
FILE SEC 24 29-14W
BOOK PAGE 121 LINE 32

Clyde W. Goddard

Sworn to and subscribed before me this 22nd day of June, 1944

Marian L. Raymond

My commission expires March 27th, 1948.

