


STATE OF KANSAS
STATE CORPORATION COMMISSION

Give All Information Completely
Make Required Affidavit
Mail or Deliver Report to:
Conservation Division
State Corporation Commission
211 No. Broadway
Wichita, Kansas

WELL PLUGGING RECORD

NORTH

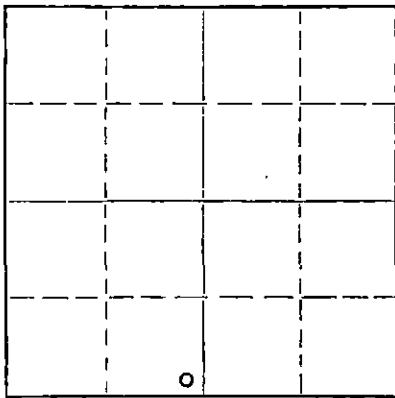

Locate well correctly on above
Section Plat

Reno County, Sec. 21 Twp. 24S Rge. (E) 5W(W)
Location as "NE/CNW/SW" or footage from lines SE/4 SE/4 SW/4
Lease Owner Messman-Rinehart Oil Company
Lease Name Yoder "A" Well No. 1
Office Address 518 Petroleum Building, Wichita, Kansas
Character of Well (completed as Oil, Gas or Dry Hole) Dry Hole
Date well completed July 10 1959
Application for plugging filed July 10 1959
Application for plugging approved July 10 1959
Plugging commenced July 11 1959
Plugging completed July 11 1959
Reason for abandonment of well or producing formation Dry

If a producing well is abandoned, date of last production 19____
Was permission obtained from the Conservation Division or its agents before plugging was commenced? yes

Name of Conservation Agent who supervised plugging of this well Fred W. Hampel, Pretty Prairie, Kansas
Producing formation _____ Depth to top _____ Bottom _____ Total Depth of Well 3575 Feet
Show depth and thickness of all water, oil and gas formations.

OIL, GAS OR WATER RECORDS

CASING RECORD

FORMATION	CONTENT	FROM	TO	SIZE	PUT IN	PULLED OUT
				10-3/4"	180'	none

Describe in detail the manner in which the well was plugged, indicating where the mud fluid was placed and the method or methods used in introducing it into the hole. If cement or other plugs were used, state the character of same and depth placed, from _____ feet to _____ feet for each plug set.

Bottom plug @ 170 ft. w/1/4 sk.
hulls and 20 sx. cement. Top
plug @ 35 ft. w/1/2 sk. hulls
and 10 sx. cement. Mud to surface.

(If additional description is necessary, use BACK of this sheet)

Name of Plugging Contractor Messman-Rinehart Oil Company
Address 518 Petroleum Building, Wichita, Kansas

STATE OF Kansas, COUNTY OF Sedgwick, ss.

J. A. Gilliland (employee of owner) of the above-described well, being first duly sworn on oath, says: That I have knowledge of the facts, statements, and matters herein contained and the log of the above-described well as filed and that the same are true and correct. So help me God.

(Signature)

518 Petroleum Bldg., Wichita, Kansas
(Address)

SUBSCRIBED AND SWORN TO before me this 21st day of July, 19 59

Barbara J. Scott, Notary Public.

My commission expires December 1, 1960



NO. 1 YODER "H"Well Log

Location: SE/4 SE/4 SW/4
Section 21-24S-5W
Reno County, Kansas

Commenced: June 29, 1959

Completed: July 10, 1959

Operator: Messman-Rinehart Oil Company
518 Petroleum Building
Wichita, Kansas

Elevation: 1549' K/S

Production: O & A

Contractor: Messman-Rinehart Oil Company
518 Petroleum Building
Wichita, Kansas

Casing Record: 10-3/4" @ 180 ft. w/150 sx. cas.

*** LOG ***

Clay	35
Sand	50
Shale & Shells	135
Red Bed & Shells	180
Shale & Shells	840
Lime & Shale	995
Streaks of Anhydrite	1020
Lime & Shale	1035
Lime & Shale	1395
Lime, Shale & Chert	1595
Lime & Shale	1755
Lime & Shale	1800
Shale & Lime	2000
Lime & Shale	2200
Lime & Shale	2660
Sand	2762
Lime & Shale	2835
Lime & Shale	3480
Chert, Lime & Shale	3525
Lime, Shale & Chalk	3575 R.T.D.

Sample Tops:

2610 - Heabner (-1061)
2800 - Lansing (-1251)
3501 - Mississippian (-1952)

The undersigned, MESSMAN-RINEHART OIL COMPANY, hereby certifies that the above log is a true and correct log of the formation encountered in drilling the above well as reflected by the Daily Drilling Reports.

MESSMAN-RINEHART OIL COMPANY

By: J. A. Gilliland

Subscribed and sworn to before me
this 21st day of July, 1959.

Barbara J. Scott
Barbara J. Scott, Notary Public

My Commission Expires: December 1, 1960