

STATE OF KANSAS  
STATE CORPORATION COMMISSION

WELL PLUGGING RECORD


Give All Information Completely  
Make Required Affidavit  
Mail or Deliver Report to:  
Conservation Division  
State Corporation Commission  
800 Bittling Building  
Wichita, Kansas

OR

FORMATION PLUGGING RECORD

Strike out upper line  
when reporting plug-  
ging off formations.

Reno County, Sec. 13 Twp. 24 Rge. 5 (W)  
Location as "NE 1/4 NW 1/4 SW 1/4" or footage from lines SE 1/4 - SE 1/4 NE 1/4 SW 1/4  
Lease Owner H. C. Bennett  
Lease Name Bauman Well No. 1  
Office Address Wichita, Kansas  
Character of Well (completed as Oil, Gas or Dry Hole) Dry hole  
Date well completed..... 19.....  
Application for plugging filed..... 19.....  
Application for plugging approved..... 19.....  
Plugging commenced..... 8/24..... 1949.....  
Plugging completed..... 9/6..... 1949.....  
Reason for abandonment of well or producing formation..... Dry hole  
If a producing well is abandoned, date of last production..... 19.....  
Was permission obtained from the Conservation Division or its agents before plugging was com-  
menced?..... Yes.....

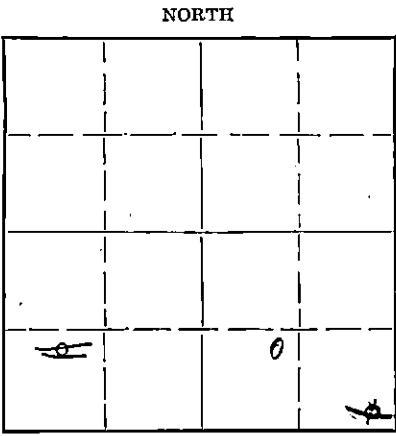

Locate well correctly on above  
Section Plat

Name of Conservation Agent who supervised plugging of this well.....  
Producing formation Mississippi Chat Depth to top..... Bottom..... Total Depth of Well..... Feet  
Show depth and thickness of all water, oil and gas formations.

OIL, GAS OR WATER RECORDS

CASING RECORD

Formation	Content	From	To	Size	Put In	Pulled Out
		0	552	8 1/4"	552	None
		0	3354	5 1/2"	3354	2,801.07'

Describe in detail the manner in which the well was plugged, indicating where the mud fluid was placed and the method or methods used in introducing it into the hole. If cement or other plugs were used, state the character of same and depth placed, from..... feet to..... feet for each plug set.

Fill with sand to 3345'  
8 sacks cement 3345'  
filled with mud to 350'  
15 sacks cement.  
filled with mud to bottom of cellar  
5 sacks cement in bottom of cellar.

RECORDED

SEP 9 1949 9-9-49  
STATE CORPORATION  
COMMISSION  
KANSAS

Correspondence regarding this well should be addressed to.....  
Address.....

STATE OF Kansas, COUNTY OF Reno  
Walker Drilling Co. (employee of owner) or (owner or operator) of the above-described well,  
being first duly sworn on oath, says: That I have knowledge of the facts, statements, and matters herein contained and the log of the above-  
described well as filed and that the same are true and correct. So help me God.

(Signature) H. M. Walker

Hutchinson, Kansas (Address)

SUBSCRIBED AND SWORN to before me this SEP 8 1949 day of....., 19.....

[Signature]  
Notary Public.  
Felder

My commission expires June 23, 1951  
My commission expires.....  
**PLUGGING**  
FILE SEC 13 T 24 R 50  
BOOK PAGE 113 LINE 9

WELL LOG BUREAU—KANSAS GEOLOGICAL SOCIETY  
508 E. Murdock, Wichita, Kansas


Company - B & R DRG., ET AL  
Farm - Bauman No. 1

SEC. 13 T. 24 S. 5W  
NE SW SE

Total Depth. 3415  
Comm. 7-8-49 Comp. 7-26-49  
Shot or Treated.  
Contractor.  
Issued. 10-8-49

County. Reno

KANSAS

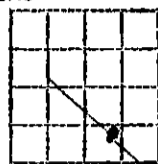

Elevation. \_\_\_\_\_

Production. Dry

CASING:  
8 5/8" 534 com. w/400 sx.  
5 1/2" 3354 com. w/50 sx.

Figures Indicate Bottom of Formations.

sand	30
sand & clay	75
sand, clay, & shale	525
shale sdy	541
lime & shale	830
lime	1010
red bed	1025
shale & shells	1065
lime	1185
lime & shale	1285
shale & shells	1435
shale & red bed	1480
shale & shells	1605
shale & red bed, lime	1735
shale & shells	1925
shale & lime	2112
shale & lime shells	2225
lime & shale	2247
lime	2300
lime & shale	2475
shale & lime shells	2575
lime	2615
lime & shale	2635
lime	2690
lime & shale	2695
lime	2717
lime & shale	2745
shale, lime & shells	2770
shale & lime	2820
lime	2825
lime, shale, & chert	2865
lime	2905
lime & shale	3345
shale & chat RTD	3360
chat	3362
chat little gas	3371
chat show oil, gas wtr	3378
chat more wtr	3382
chat coarse	3395
chat wh fine	3397
chat coarse show oil	3401
chat hrd lime	3407
chat hrd lime	3415

Total Depth  
Tops:  
Mississippi 3339

RECEIVED

Conservation Div.

OCT 8 X 1949

10-8-49

STATE CORPORATION  
COMMISSION  
KANSAS

PLUGGING  
FILE SEC 13 T 24 S 5W  
BOOK PAGE 113 LINE 9