

STATE OF KANSAS
STATE CORPORATION COMMISSION

Give All Information Completely
Make Required Affidavit
Mail or Deliver Report to:
Conservation Division
State Corporation Commission
212 North Market, Insurance Bldg.
Wichita, Kansas

R
WELL PLUGGING RECORD

Reno County. Sec. 4 Twp. 24 Rge. 5 (E) W (W)

Location as "NE/CNW/SW" or footage from lines NE NW SW

Lease Owner Drilling & Exploration Co., Inc.

Lease Name Baker #1 Well No. _____

Office Address Wichita, Kansas

Character of Well (completed as Oil, Gas or Dry Hole) _____

Date well completed _____ 19__

Application for plugging filed _____ 19__

Application for plugging approved _____ 19__


Plugging commenced 4-13-60 _____ 19__

Plugging completed 4-18-60 _____ 19__

Reason for abandonment of well or producing formation _____

If a producing well is abandoned, date of last production _____ 19__

Was permission obtained from the Conservation Division or its agents before plugging was commenced? yes

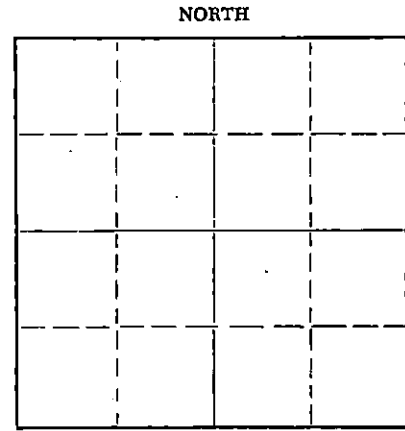

Locate well correctly on above Section Plat

Name of Conservation Agent who supervised plugging of this well Fred Hampel

Producing formation _____ Depth to top _____ Bottom _____ Total Depth of Well 3900 Feet

Show depth and thickness of all water, oil and gas formations.

OIL, GAS OR WATER RECORDS

CASING RECORD

FORMATION	CONTENT	FROM	TO	SIZE	PUT IN	PULLED OUT
				10-3/4"	228'	none
				4-1/2"	3879'	3391'

Describe in detail the manner in which the well was plugged, indicating where the mud fluid was placed and the method or methods used in introducing it into the hole. If cement or other plugs were used, state the character of same and depth placed, from _____ feet to _____ feet for each plug set.

Checked the hole to 3878' and found it open.
Filled w/sand to 3820' and dumped 4 sacks of cement with bailer. Pulled 4 1/2" casing.
Cleared hole and mudded the hole from 450' to 220', set rock bridge to 210' and dumped 25 sacks of cement. Mudded the hole to 35', set rock bridge and ran 15 sacks of cement to base of cellar.

4-26-60

Plugging Completed

RECEIVED
STATE CORPORATION COMMISSION

APR 26 1960

Name of Plugging Contractor Knight Casing Pulling Co.
Address Chase, Kansas

CONSERVATION DIVISION
Wichita, Kansas

STATE OF KANSAS COUNTY OF RICE, ss.
I, Noel J. Knight (employee of owner) or (~~owner or operator~~) of the above-described

well, being first duly sworn on oath, says: That I have knowledge of the facts, statements, and matters herein contained and the log of the above-described well as filed and that the same are true and correct. So help me God.

(Signature) Noel J. Knight
Chase, Kansas
(Address)

SUBSCRIBED AND SWORN TO before me this 20th day of April, 19 60

My commission expires 9-27-62

Thomas V. Duggan
Notary Public.



DRILLING AND EXPLORATION COMPANY, INC.

Dallas, Texas

DRILLERS WELL LOG

Baker #1

NE NW SW Sec. 4-24S-5W

Reno County, Kansas

Elevation: 1506 K.B.

Commenced R.D.: 12-23-59

Initial Production: D&A

Completed R.D.: 1-11-60

Contractor: Mack Oil Co.

Total Depth: 3900'

Casing Record: 228' 8-5/8" OD surface casing
3899' 4-1/2" OD production casing

<u>STRATA</u>	<u>DEPTH</u>
Sand	0 - 140'
Shale	140 - 615'
Salt	615 - 700'
Shale & Shells	700' - 800'
Lime	800' - 1385'
Shale & Shells	1385' - 2395'
Lime	2395' - 2533'
Shale & Lime	2533' - 2795'
Lime	2795' - 2952'
Lime & Chert	2952' - 2997'
Lime	2997' - 3275'
Lime & Shale	3275' - 3380'
Lime	3380' - 3586'
Shale & Lime	3586' - 3846'
Lime	3846' - 3862'
Sand	3862' - 3882'
Sand and Shale	3882' - 3900'

RECEIVED
CORPORATION COMMISSION

FEB 16 1960

CONSERVATION DIVISION
Wichita, Kansas

2-16-60

I hereby certify that the above is a true and correct log of said well as reflected by the daily drilling reports.

MACK OIL COMPANY

By Harold L. Steincamp

Signed and sworn to in my presence this 15th day of February, 1960, by Harold L. Steincamp, a representative of Mack Oil Company.

Elizabeth K. SuttonElizabeth K. Sutton
Notary Public

My Commission Expires: May 6, 1961