


Give All Information Completely
Make Required Affidavit
Mail or Deliver Report to:
Conservation Division
State Corporation Commission

WELL PLUGGING RECORD

P. O. Box 17027
Wichita, Kansas 67217
NORTH

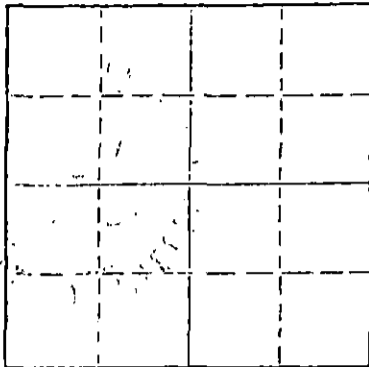

Locate well correctly on above
Section Plat

Stafford County, Sec. 7 Twp. 25 Rge. 14 (E) (W) X
Location as "NE/CNW/SW" or footage from lines SE NW SE
Lease Owner Nadel & Gussman
Lease Name James Ulsch Well No. #2
Office Address Box 14 Great Bend, Kansas
Character of Well (completed as Oil, Gas or Dry Hole)
Date well completed 19____
Application for plugging filed 19____
Application for plugging approved 19____
Plugging commenced 9-7-74 19____
Plugging completed 9-27-74 19____
Reason for abandonment of well or producing formation

If a producing well is abandoned, date of last production 19____
Was permission obtained from the Conservation Division or its agents before plugging was commenced?

Name of Conservation Agent who supervised plugging of this well G. R. Biberstein
Producing formation Depth to top Bottom Total Depth of Well 4247'
Show depth and thickness of all water, oil and gas formations.

OIL, GAS OR WATER RECORDS

CASING RECORD

FORMATION	CONTENT	FROM	TD	SIZE	PUT IN	PULLED OUT
				5 1/2"	4246'	2608.20'
				8 5/8"	298'	

Describe in detail the manner in which the well was plugged, indicating where the mud fluid was placed and the method or methods used in introducing it into the hole. If cement or other plugs were used, state the character of same and depth placed, from feet to feet for each plug set.

Made bottom hole plug back with sand to 4170'. Mixed and ran 5 sacks cement thru dump bailer.
Plug hole with 3 sacks hulls - 10 sacks gel and 100 sacks cement

RECEIVED
STATE CORPORATION COMMISSION
SEP 30 1974
CONSERVATION DIVISION
Wichita, Kansas

(If additional description is necessary, use BACK of this sheet)
Name of Plugging Contractor Southwest Casing Pulling Co.
Address Box 364 Great Bend, Kansas

STATE OF Kansas COUNTY OF Barton, ss.
Southwest Casing Pulling Co. (employee of owner) or (owner or operator) of the above-described

well, being first duly sworn on oath, says: That I have knowledge of the facts, statements, and matters herein contained and the log of the above-described well as filed and that the same are true and correct. So help me God.

(Signature) W. C. Spencer Sec.
Box 364 Great Bend, Kansas
(Address)

Subscribed and sworn to before me this 28 day of Sept., 1974



24 October 1976
Sidney D. Miller
Notary Public.

Apache Oil Company - Owner

JAMES WILSON #2

Total Depth: 4247'

Comm: 11/25/58

Comp: 12/6/58

Casings:

3 5/8 @ 298

5 1/2 @ 4248

Sierra Petroleum - Contr.

SE NW SE Sec. 7-25S-14W
Stafford County, Kansas

Elev: 2004 KB

Cement: k

with 250 sacks cement

with 100 sacks cement

FORMATION	DEPTH
Sand	155
Shale	260
Red Bed	948
Anhydrite	969
Shale & shells	1345
Shale & Salt	1460
Shale, shells & salt	1833
Shale & lime	3488
Lime	3603
Lime & shale	3822
Lime	4125
Lime & shale	4190
Lime	4193
Chert & shale	4248
Top: Anhydrite	948
Mississippi	4179

RECEIVED
STATE CORPORATION COMMISSION
APR 26 1974
CONSERVATION DIVISION
(Wichita, Kansas)

STATE OF KANSAS }
COUNTY OF RUSSELL } ss:

I hereby certify that the above information is true and correct to the best of my knowledge.

C. P. Souder

Subscribed and sworn to before me this 8th day of December, 1958.

Margie Cooper
Notary Public

My commission expires: 1-30-61.