


STATE OF KANSAS
STATE CORPORATION COMMISSION

WELL PLUGGING RECORD

Give All Information Completely
Make Required Affidavit
Mail or Deliver Report to:
Conservation Division
State Corporation Commission
211 No. Broadway
Wichita, Kansas

Stafford County, Sec. 8 Twp. 25 Rge. 14 (X) (W)
Location as "NE/CNW/SW" or footage from lines NE NE NE
Lease Owner Carl Hines
Lease Name Moore Well No. 1
Office Address Orpheum Building - Wichita, Kansas
Character of Well (completed as Oil, Gas or Dry Hole) Dry Hole
Date well completed September 2 19 57
Application for plugging filed September 2 19 57
Application for plugging approved September 2 19 57
Plugging commenced September 2 19 57
Plugging completed September 2 19 57
Reason for abandonment of well or producing formation Dry

NORTH

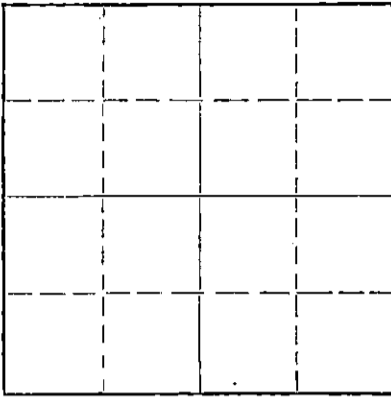

Locate well correctly on above
Section Plat

If a producing well is abandoned, date of last production _____ 19____
Was permission obtained from the Conservation Division or its agents before plugging was commenced? yes

Name of Conservation Agent who supervised plugging of this well _____
Producing formation Viola Lime Depth to top 4257 Bottom 4270 Total Depth of Well 4270 Feet
Show depth and thickness of all water, oil and gas formations.

OIL, GAS OR WATER RECORDS

CASING RECORD

FORMATION	CONTENT	FROM	TO	SIZE	PUT IN	PULLED OUT
					none	

Describe in detail the manner in which the well was plugged, indicating where the mud fluid was placed and the method or methods used in introducing it into the hole. If cement or other plugs were used, state the character of same and depth placed, from _____ feet to _____ feet for each plug set.

Set bottom plug @300'
Plug #1 - 20 sacks cement, fluid to 25#. Set top plug 1/3 sack hulls 5 sacks cement.

RECEIVED
STATE CORPORATION COMMISSION

APR 13 1958

CONSERVATION DIVISION
Wichita, Kansas

4-18-58

(If additional description is necessary, use BACK of this sheet)

Name of Plugging Contractor L. C. Smitherman Drilling Company
Address Box 627 - Augusta, Kansas

STATE OF Kansas, COUNTY OF Butler, ss.
Carl J. Lehr (employee of owner) or (owner or operator) of the above-described well, being first duly sworn on oath, says: That I have knowledge of the facts, statements, and matters herein contained and the log of the above-described well as filed and that the same are true and correct. So help me God.

(Signature) Carl J. Lehr
Box 627 - Augusta, Kansas
(Address)

SUBSCRIBED AND SWORN TO before me this 5th day of September, 1957

My commission expires January 28, 1961
Shirley Ann Jackson
Shirley Ann Jackson Notary Public.

PLUGGING
FILE SEC 8 T 25 R 14
BOOK PAGE 42 LINE 15

MOORE #1

Company: Smitherman & Hines
 Contractor: L. C. Smitherman Drilling Co.
 Commenced: August 21, 1957
 Completed: September 2, 1957

Location: NE NE NE, Sec. 8-25-14W,
 Stafford Co., Kansas
 Elevation: KB - 1995
 Casing: 480' - 8 5/8" cemented w/300 sks

Figures Indicate Bottoms of Formations;

Depth	Formation
0	72 Sand and Gravel
72	198 Sand
198	479 Shale
479	700 Red Bed and Shale
700	890 Sand and Red Bed
890	915 Lime (Anhydrite)
915	1750 Shale
1750	1830 Shale and Lime Streaks
1830	2058 Lime (Ft. Riley)
2058	2116 Shale and Lime Streaks
2116	2360 Shale and Lime
2360	2489 Shale and Lime Streaks
2489	2950 Shale and Lime
2950	3070 Shale and Lime Streaks
3070	3275 Shale and Lime
3275	3360 Lime w/Shale Streaks
3360	3494 Lime and Shale
3494	3575 Lime
3575	3600 Lime and Shale Streaks
3600	3690 Lime and Shale
3690	3749 Shale
3749	3812 Lime
3812	3886 Lime and Shale Streaks
3886	4025 Lime
4025	4092 Lime and Shale
4092	4143 Lime
4143	4165 Lime (Mississippi)
4165	4175 Lime
4175	4200 Shale and Lime
4200	4257 Shale and Lime Streaks
4257	4270 Viola Lime
4270	Total Depth

RECEIVED
 STATE CORPORATION COMMISSION
 APR 18 1958
 CONSERVATION DIVISION
 Wichita, Kansas

We hereby certify the above and foregoing to be a true and correct copy of the Log on the Moore #1, located in the NE NE NE of Section 8-25-14W, Stafford County, Kansas.

L. C. SMITHERMAN DRILLING COMPANY

Carl J. Lehr
 Carl J. Lehr

Subscribed and sworn to before me this 2nd day of December, 1957.

Shirley Ann Jackson
 (Notary Public)

My commission expires January 28, 1961.

PLUGGING
 FILE SEC. 8 T. 25 R. 14W
 BOOK PAGE 12 LINE 15