


STATE OF KANSAS  
STATE CORPORATION COMMISSION

WELL PLUGGING RECORD

Give All Information Completely  
Make Required Affidavit  
Mail or Deliver Report to:  
Conservation Division  
State Corporation Commission  
211 No. Broadway  
Wichita, Kansas

NORTH

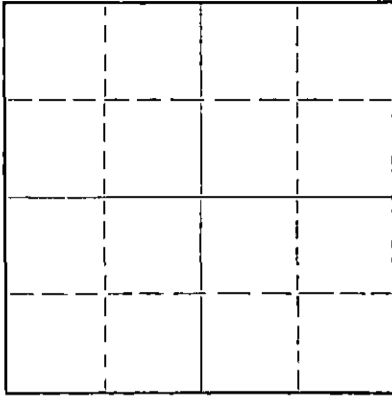

Locate well correctly on above  
Section Plat

STAFFORD County, Sec. 8 Twp. 25S Rge. 14 (X) W (W)  
Location as "NE/CNW/SW" or footage from lines NW, SE, SW  
Lease Owner TIME PETROLEUM COMPANY  
Lease Name JORDAN-WATERS Well No. 1  
Office Address SUITE 560 NORTH, 4th NATIONAL BANK BLDG, WICHITA  
Character of Well (completed as Oil, Gas or Dry Hole) DRY ROTARY  
Date well completed MAY 17, 1959  
Application for plugging filed MAY 17, 1959  
Application for plugging approved MAY 16, 1959  
Plugging commenced MAY 17, 1959  
Plugging completed MAY 17, 1959  
Reason for abandonment of well or producing formation NO PRODUCTIBLE ZONE

If a producing well is abandoned, date of last production \_\_\_\_\_ 19\_\_\_\_  
Was permission obtained from the Conservation Division or its agents before plugging was commenced? YES

Name of Conservation Agent who supervised plugging of this well MR. FRANK BROADFOOT  
Producing formation \_\_\_\_\_ Depth to top \_\_\_\_\_ Bottom \_\_\_\_\_ Total Depth of Well 4218 Feet  
Show depth and thickness of all water, oil and gas formations.

OIL, GAS OR WATER RECORDS

CASING RECORD

FORMATION	CONTENT	FROM	TO	SIZE	PUT IN	PULLED OUT
				8 5/8"	347'	

Describe in detail the manner in which the well was plugged, indicating where the mud fluid was placed and the method or methods used in introducing it into the hole. If cement or other plugs were used, state the character of same and depth placed, from \_\_\_\_\_ feet to \_\_\_\_\_ feet for each plug set.

Filled hole to 270' w/heavy mud, pushed wooden plug & 1/4 sx. hulls to 270', pumped 20 sx. cement through drill pipe on plug.  
Filled hole to 40' w/heavy mud, pushed wooden plug, 1/4 sx. hulls to 40', pumped 10 sx. cement on plug and up to base of well cellar.

RECEIVED  
STATE CORPORATION COMMISSION

8-4-59

(If additional description is necessary, use BACK of this sheet)

Name of Plugging Contractor GARVEY DRILLING COMPANY  
Address ROUTE #2, GREAT BEND, KANSAS

STATE OF KANSAS, COUNTY OF BARTON, ss.  
VERNE A. MORRIS (employee of owner) ~~XXXXXX~~ of the above-described well, being first duly sworn on oath, says: That I have knowledge of the facts, statements, and matters herein contained and the log of the above-described well as filed and that the same are true and correct. So help me God.

(Signature) Verne A. Morris  
ROUTE #2, GREAT BEND, KANSAS  
(Address)

SUBSCRIBED AND SWORN TO before me this 31st day of July, 1959

My commission expires November 12, 1962

*Boamfubuy*

Notary Public.

PLUGGING  
FILE SEC. 8 T. 25R. 14W  
BOOK PAGE 59 LINE 2

# WELL LOG

MAY 28 1959

COMPANY TIME PETROLEUM COMPANY

SEC. 8 T. 25S R. 14W

FARM J. W. JORDAN NO. 1

LOC. NW, SE, SW


TOTAL DEPTH 4218'

COUNTY STAFFORD CO., KANSAS

COMM. May 7, 1959

COMP. May 17, 1959

CONTRACTOR GARVEY DRILLING COMPANY

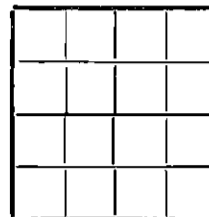

CASING 8 5/8" @ 347' W/275 sax.

ELEVATION 1989' DF

PRODUCTION D & A

FIGURES INDICATE BOTTOM OF FORMATIONS

150	Sand & gravel
190	Shale
290	Blue shale
905	Red bed
925	Anhydrite
1430	Shale
1895	Shale & lime streaks
2050	Lime & shale streaks
2385	Lime
3370	Shale & lime
3535	Lime & shale
3618	Lime
3845	Lime & shale
4132	Lime
4208	Lime & shale
4218	Lime & chert
4218	T. D.

RECEIVED  
STATE CORPORATION COMMISSION  
FEB 14 1963  
CONSERVATION DIVISION  
Wichita, Kansas

State of KANSAS }  
County of BARTON } ss:

I, VERNE A. MORRIS of GARVEY DRILLING COMPANY

upon oath state that the above and foregoing is a true and correct copy of the log of the #1 J. W. JORDAN well

Subscribed and sworn to before me this 27th day of May 19 59

My Commission Expires: November 12, 1962

Verne A. Morris  
Brainfunder  
NOTARY PUBLIC