


STATE OF KANSAS
STATE CORPORATION COMMISSION

WELL PLUGGING RECORD

Give All Information Completely
Make Required Affidavit
Mail or Deliver Report to:
Conservation Division
State Corporation Commission
211 No. Broadway
Wichita, Kansas

Stafford County, Sec. 9 Twp. 25 Rge. 14 (E) W (W)
Location as "NE/CNW/SW" or footage from lines SW SE SW
Lease Owner Cities Service Oil Company
Lease Name Hammond Well No. 2
Office Address Box 144, Great Bend, Kansas
Character of Well (completed as Oil, Gas or Dry Hole) Dry Hole
Date well completed December 6, 19 57
Application for plugging filed December 6, 19 57
Application for plugging approved December 6, 19 57
Plugging commenced December 6, 19 57
Plugging completed December 6, 19 57
Reason for abandonment of well or producing formation Dry Hole

NORTH

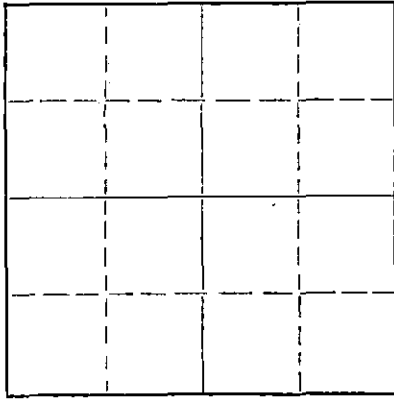

Locate well correctly on above
Section Plat

If a producing well is abandoned, date of last production --- 19---
Was permission obtained from the Conservation Division or its agents before plugging was com-
menced? Yes

Name of Conservation Agent who supervised plugging of this well F. Broadfoot
Producing formation Lansing Depth to top 3730 Bottom 4035 Total Depth of Well 4035 Feet
Show depth and thickness of all water, oil and gas formations.

OIL, GAS OR WATER RECORDS

CASING RECORD

FORMATION	CONTENT	FROM	TO	SIZE	PUT IN	PULLED OUT
				409'	8-5/8"	None

Describe in detail the manner in which the well was plugged, indicating where the mud fluid was placed and the method or methods used in introducing it into the hole. If cement or other plugs were used, state the character of same and depth placed, from _____ feet to _____ feet for each plug set.

4035-300', heavy mud.
300-238', wood plug, 1/3 sack hulls and 20 sacks cement.
238- 35', heavy mud.
35' to base of cellar, wood plug, 1/3 sack hulls and 10 sacks cement.

(If additional description is necessary, use BACK of this sheet)

Name of Plugging Contractor Glenn Peel Drilling Company
Address Hoisington, Kansas

STATE OF Kansas, COUNTY OF Barton, ss.
V. M. Conover (employee of owner) or owner or operator of the above-described well, being first duly sworn on oath, says: That I have knowledge of the facts, statements, and matters herein contained and the log of the above-described well as filed and that the same are true and correct. So help me God.

(Signature) V. M. Conover
Box 144, Great Bend, Kansas
(Address)

SUBSCRIBED AND SWORN TO before me this 11th day of December, 1957.

My commission expires March 12, 1959.

RECEIVED
STATE CORPORATION COMMISSION

N. S. Smith
Notary Public.

DEC 19 1957
CONSERVATION DIVISION
Wichita, Kansas
12-19-57

PLUGGING
FILE SEC 9 T. 25 R. 14
BOOK PAGE 68 LINE 32

WELL RECORD

WILDCAT.....
 DISCOVERY.....
 POOL.....

COMPANY Cities Service Oil Co. WELL # 2 FARM Harmond
 LOCATION 330' N. & 990' W. of S/L Cor. Section 9 Township 25 Range 14W
 ELEV. 1982 (1979) Cr. CO. Stafford STATE Kansas
 IP. Dry Hole P & A 12-6-57
 PERFS.....
 FRAC..... ACID None
 T.D. 4035' PBTD..... GRAV/GOR.....
 DRLG. COMM. 11-20-57 COMP. 12-6-57 CONTRACTOR Glenn M. Peel

CASING RECORD:

8 5/8" @ 409' with 275 sacks cement

Formation Records:

sand	0 - 150'
shale	320
red bed	410
red bed, shales & shells	810
red bed	895
anhydrite	920
red bed	1200
shale	1500
shales & lime	1845
lime & shale	1975
lime	2170
lime & shale	2410
lime	2500
shales & shells	2550
lime & shale	2675
lime, shale & shells	2945
lime & shale	3135
lime	3275
lime & shales	3568
lime	3813
lime, cherty	3860
lime	4035

Topoka	3197
Hosmer	3559
Dodge	3580
Douglas	3601
Brown Limestone	3706
Lansing	3730
Base Kansas City	4019
Total Depth	4035

DST 3772-3813, open 1 hr, rec. 240' muddy salt water & 455' salt water; EMP 1210#/30 minutes.
 DST 3861-77, open 1 hr, rec. 35' slightly oil-spotted mud & 5' muddy water; EMP 790#/30 minutes.
 DST 3879-3908, open 1 hr, rec. 39' mud; EMP 1142#/30 minutes
 DST 3909-27, open 1 hr, rec. 90' muddy salt water; EMP 1278#/30 minutes.
 DST 3939-54, open 1 hr, rec. 5' oily mud, 30' watery mud with show oil, & 65' muddy salt water; EMP 1020#/30 minutes.

Slope Tests (Syfo)

100' - 1°
 500' - 0°
 1500' - 0°
 2000' - 2°
 2650' - 0°
 3000' - 1°
 3500' - 0

RECEIVED
 STATE CORPORATION COMMISSION

DEC 19 1957 T.D.

CONSERVATION DIVISION
 Wichita, Kansas

PLUGGING

FILE SEC 9 T. 25 R. 14W
 BOOK PAGE 68 LINE 32