


STATE OF KANSAS
STATE CORPORATION COMMISSION

Form CP-4

Give All Information Completely
Make Required Affidavit
Mail or Deliver Report to:
Conservation Division
State Corporation Commission
211 No. Broadway
Wichita, Kansas

WELL PLUGGING RECORD

T - 25 NORTH R - 14W

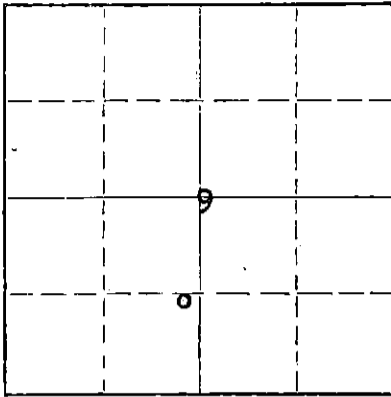

Locate well correctly on above
Section Plat

Stafford County, Sec. 9 Twp. 25 Rge. 14 (E) W (W)
Location as "NE/CNW/SW" or footage from lines NE-SE SW/4
Lease Owner Frank J. Black
Lease Name Hammond Well No. 1
Office Address McPherson, Kansas
Character of Well (completed as Oil, Gas or Dry Hole) Oil
Date well completed 8-27-57 19
Application for plugging filed 4-22-65 19
Application for plugging approved 4-23-65 19
Plugging commenced 4-25-65 19
Plugging completed 5-4-65 19
Reason for abandonment of well or producing formation Depleted.

If a producing well is abandoned, date of last production 19
Was permission obtained from the Conservation Division or its agents before plugging was commenced? yes

Name of Conservation Agent who supervised plugging of this well Archie Elving
Producing formation _____ Depth to top _____ Bottom _____ Total Depth of Well 4011 Feet
Show depth and thickness of all water, oil and gas formations.

OIL, GAS OR WATER RECORDS

CASING RECORD

FORMATION	CONTENT	FROM	TO	SIZE	PUT IN	PULLED OUT
				8-5/8"	408'	None
				5-1/2"	4011'	2043'

Describe in detail the manner in which the well was plugged, indicating where the mud fluid was placed and the method or methods used in introducing it into the hole. If cement or other plugs were used, state the character of same and depth placed, from _____ feet to _____ feet for each plug set.

Checked hole to 4011', sanded to 3995' and dumped 5 sacks of cement @ 3995' with dump bailer. Pulled 5 1/2" casing, set rock bridge from 300' to 285' and dumped 1 sack of Cal Seal. Bailed fluid from surface to 280' and dumped 25 sacks of cement. Mudded hole to 40', set rock bridge to 30' and ran 10 sacks of cement to base of cellar.

PLUGGING COMPLETE.

RECEIVED
STATE CORPORATION COMMISSION
MAY 11 1965
CONSERVATION DIVISION
Wichita, Kansas

(If additional description is necessary, use BACK of this sheet)
Name of Plugging Contractor KNIGHT CASING PULLING COMPANY License #436
Address CHASE, KANSAS

STATE OF KANSAS, COUNTY OF RICE, ss.
Noel J. Knight (employee of owner) or (owner or operator) of the above-described well, being first duly sworn on oath, says: That I have knowledge of the facts, statements, and matters herein contained and the log of the above-described well as filed and that the same are true and correct. So help me God.

(Signature) Noel J. Knight
Chase, Kansas
(Address)

SUBSCRIBED AND SWORN TO before me this 6th day of May, 1965

My commission expires May 20, 1968

Milton J. Vrlin
Notary Public.


WELL LOG BUREAU--KANSAS GEOLOGICAL SOCIETY
508 East Murdock, Wichita, Kansas

Company- **CITIES SERVICE OIL CO.**
Farm- **Hammond** No. **1**

SEC. **9** T. **25** R. **14W**
NE SE SW
990' N, 330' W of S/4
Cor.

Total Depth. **4011'** PB **3999'**
Comm. **8-10-57** Comp. **8-27-57**
Shot or Treated.
Contractor. **Glenn W. Peel**
Issued. **12-14-57**

County **Stafford**
KANSAS

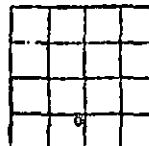

CASING:
8 5/8" 408' cem w/275. sx.
5 1/2" 4011' cem w/150 sx.

Elevation. **1973'** Gr.

Production. **Phy. Pot. 171 BO,**
3 1/2 BW, 24 hra.

Figures Indicate Bottom of Formations.

sand and shale	408
red bed	890
anhydrite	930
shale	1550
salt, shale & shells	1880
lime	2060
lime & shale	2120
shale and lime	2540
lime & shale	2620
shale & lime	3000
lime & shale	3305
lime	3435
lime & shale	3690
lime	3940
lime & shale	4017
Total Depth	4017 = 4011 SLM
Plugged back to	3999'
TOPS: Corr.	
Topeka	3123
Heebner	3535
Dodge	3558
Douglas	3573
Brown Limestone	3683
Lansing	3708
Base Kansas City	3994

RTD

Perf. 33 shots 3919-28.
Perf. 17 shots 3877-81.
Perf. 41 shots 3863-73.

Acidizing Record:
1500 gals. 3919-28
1000 gals. 3877-81
1500 gals. 3863-73

RECEIVED
STATE CORPORATION COMMISSION
MAY 11 1965
CONSERVATION DIVISION
Wichita, Kansas