


RECEIVED  
STATE CORPORATION COMMISSION

STATE OF KANSAS  
STATE CORPORATION COMMISSION  
CONSERVATION DIVISION  
P. O. BOX 17027  
WICHITA, KANSAS 67217

MAR 13 1976  
03-13-75  
CONSERVATION DIVISION  
WELL PLUGGING RECORD  
Wichita, Kansas

FORM CP-4

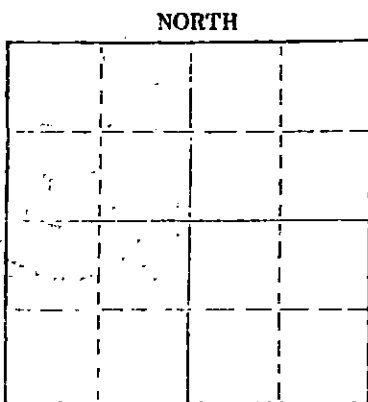

Locate well correctly on above  
Section Plat

Russell County. Sec. 18 Twp. 12 Rge. 15 (E) W (W)  
Location as "NE/CNW/SE" or footage from lines NW NE SE  
Lease Owner Dreiling Oil, Inc.  
Lease Name Mermis Well No. 4  
Office Address Rt. #2, Victoria, KS 67671  
Character of Well (completed as Oil, Gas or Dry Hole) Oil well  
Date well completed 6-24 1959  
Application for plugging filed 2-26 1975  
Application for plugging approved 3-5 1975  
Plugging commenced 3-6 1975  
Plugging completed 3-6 1975  
Reason for abandonment of well or producing formation Depleted

If a producing well is abandoned, date of last production December 1974  
Was permission obtained from the Conservation Division or its agents before plugging was commenced? yes

Name of Conservation Agent who supervised plugging of this well Dale Balthazor, 189 First St. Phillipsburg, KS  
Producing formation \_\_\_\_\_ Depth to top \_\_\_\_\_ Bottom \_\_\_\_\_ Total Depth of Well 3,369 Feet  
Show depth and thickness of all water, oil and gas formations.

OIL, GAS OR WATER RECORDS

CASING RECORD

FORMATION	CONTENT	FROM	TO	SIZE	PUT IN	PULLED OUT
Surface Pipe				8 5/8"	940	0
Casing				5 1/2"	3,369'	1,400'

Describe in detail the manner in which the well was plugged, indicating where the mud fluid was placed and the method or methods used in introducing it into the hole. If cement or other plugs were used, state the character of same and depth placed, from \_\_\_\_\_ feet to \_\_\_\_\_ feet for each plug set.

Set plug at 2535', dumped 50' sand, 4 sacks cement. Plugged 25 400' with 5 1/2 yards Ready Mix.

(If additional description is necessary, use BACK of this sheet)

Name of Plugging Contractor Dreiling Oil, Inc.  
Address Rt. #2, Victoria, KS 67671

STATE OF KANSAS COUNTY OF ELLIS ss.  
I, Joseph A. Hess, Sec. Treas. of Drlg. Contr. (employee of owner) or (owner or operator) of the above-described well, being first duly sworn on oath, says: That I have knowledge of the facts, statements, and matters herein contained and the log of the above-described well as filed and that the same are true and correct. So help me God.

(Signature) Joseph A. Hess  
JOSEPH A. HESS, Hays, KS 67601  
(Address)

Subscribed AND SWORN to before me this 12 day of March, 1975

Cecilia Basgall  
Cecilia Basgall Notary Public.

My commission expires September 13, 1976.



# McWilliams & Steincamp

Petroleum Geologists

P. O. Box 355

Great Bend, Kansas

July 13, 1959

Leo J. Drilling Oil Company

#4 Mermis

NW NE SE

Section 18-12S-15W

Russell County, Kansas

Elevation 1878'

Note: This is a old hole originally drilled by Stearms Petroleum in 1949, washed down by Leo J. Drilling July 1959. The following tops are picked from electric log. Zones to be perforated are from correlations of producing zones in nearby wells.

Top Topeka 2688' (- 810')

Perforate 2840'-2848'

Perforate 2888'-2898'

Perforate 2913'-2916'

Perforate 2927'-2937'

Top Heebner 2952' (-1074')

Top Toronto 2972' (-1094')

Perforate 2974'-2980'

Top Lansing 3005' (-1127')

Perforate 3008'-3015'

Perforate 3032'-3036'

Perforate 3046'-3058'

Perforate 3100'-3104'

Perforate 3140'-3144'

Perforate 3179'-3186'

Top Conglomerate or Gorham Sand 3294' (-1416')

Perforate 3296'-3304'

RECEIVED  
STATE CORPORATION COMMISSION

JUL 14 1959

CONSERVATION DIVISION  
Wichita, Kansas

RECEIVED  
STATE CORPORATION COMMISSION

JUL 28 1959

CONSERVATION DIVISION  
Wichita, Kansas

Leo J. Drilling Oil Company  
#4 Mermis  
Page Two

ROTARY TOTAL DEPTH 3369'

5½" O. D. casing set at 3368'.

McWILLIAMS & STEINCAMP

Charles W. Steincamp

CWS:et

C  
O  
P  
Y

RECEIVED  
STATE CORPORATION COMMISSION

MAR 4 1975

CONSERVATION DIVISION  
Wichita, Kansas

WELL LOG

OPERATOR: Leo Dreiling  
Victoria, Kansas

CONTRACTOR: Mast Drilling, Inc.  
Russell, Kansas

LEASE: Mermis No. 4 (REDRILL)  
NW/4 NE/4 SE/4  
Sec. 18, T12S, R15W  
Russell, County, Kansas

COMMENCED: 6-20-59

COMPLETED: 6-24-59

FORMATION	DEPTH
Begin at	3325
Lime	3369
TOTAL DEPTH	3389

I hereby certify that the above is true and correct  
to the best of my knowledge.

Mast Drilling, Inc.

*James J. Thomas*  
JAMES J. THOMAS, Secretary.

STATE OF KANSAS )  
                          )ss  
COUNTY OF RUSSELL)

Subscribed and sworn to before me this 30th day of July, 1959.

*Betty Dean Galyard*

My Commission expires 8-9-62.

RECEIVED  
STATE CORPORATION COMMISSION

MAR 4 1955

CONSERVATION DIVISION  
Wichita, Kansas

RECEIVED  
STATE CORPORATION COMMISSION

FEB 28 1955

CONSERVATION DIVISION  
Wichita, Kansas