

STATE OF KANSAS
STATE CORPORATION COMMISSION

Give All Information Completely
Make Required Affidavit
Mail or Deliver Report to:
Conservation Division
State Corporation Commission
211 No. Broadway
Wichita, Kansas

WELL PLUGGING RECORD

Russell County. Sec. 18 Twp. 12 Rge. 15 (E) W (W)

Location as "NE/CNW/SW" or footage from lines W/2 E/2 SE

Lease Owner Leo J. Dreiling & Sons, Inc. Oil Company

Lease Name Mermis Well No. 5

Office Address Victoria, Ka.

Character of Well (completed as Oil, Gas or Dry Hole) Oil

Date well completed _____ 19____

Application for plugging filed Dec. 26, 1962

Application for plugging approved Dec. 31, 1962


Plugging commenced Dec. 26, 1962

Plugging completed Dec. 29, 1962

Reason for abandonment of well or producing formation No longer a producer.

If a producing well is abandoned, date of last production _____ 19____

Was permission obtained from the Conservation Division or its agents before plugging was commenced? Yes

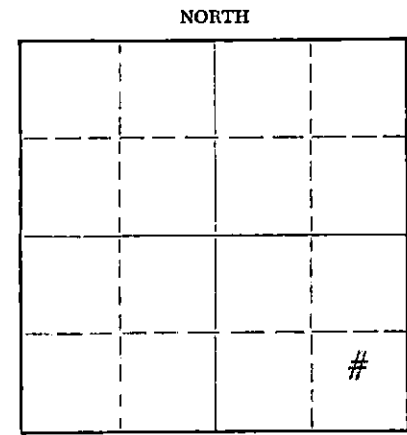

Locate well correctly on above Section Plat

Name of Conservation Agent who supervised plugging of this well Don Truan

Producing formation _____ Depth to top _____ Bottom _____ Total Depth of Well _____ Feet

Show depth and thickness of all water, oil and gas formations.

OIL, GAS OR WATER RECORDS

CASING RECORD

FORMATION	CONTENT	FROM	TO	SIZE	PUT IN	PULLED OUT
				8 5/8	158'	None
				5 1/2	3330'	2427'

Describe in detail the manner in which the well was plugged, indicating where the mud fluid was placed and the method or methods used in introducing it into the hole. If cement or other plugs were used, state the character of same and depth placed, from _____ feet to _____ feet for each plug set.

Plugged back with sand from 3005' to 2985'. Mixed and dumped 4 sx. cement from 2985' to 2953'. Pulled casing to 450'. Mixed and circulated 10 sx. of gel mud. Pulled casing to 350'. Mixed and pumped in 20 sx. cement from 350' to 290'. Pulled casing to 150'. Mixed and circulated 20 sx. cement from 150' to 90'. Pulled rest casing. Bailed off fluid to 35'. Set 5' rock bridge from 35' to 30'. Mixed and dumped 10 sx. cement from 30' to base of cellar.

MAILED COPY

JAN 7 1963

01-07-63

CONSERVATION DIVISION
WICHITA, KANSAS

(If additional description is necessary, use BACK of this sheet)

Name of Plugging Contractor Ace Pipe Pulling Co.

Address Box 304 Great Bend, Ka.

STATE OF Kansas COUNTY OF Ellis, ss.
Leo J. Dreiling, a partner (employee of owner) or (owner or operator) of the above-described well, being first duly sworn on oath, says: That I have knowledge of the facts, statements, and matters herein contained and the log of the above-described well as filed and that the same are true and correct. So help me God.

(Signature) Leo J. Dreiling

(Address)

SUBSCRIBED AND SWORN TO before me this 3rd day of January, 1963

Kenneth Zimmerman
Notary Public.

My commission expires August 14, 1965



L. J. DREILING and SONS, Inc.

VICTORIA, KANSAS

WELL LOG

Company Leo J. Dreiling Oil Company
Victoria, Kansas

Sec. 18 Twp. 12 Rng. 15

Farm Mermis No. 5

Location W/2 E/2 SE

Total Depth 3340'

County Ellis

Comm. 11-10-60 Comp. 11-18-60

Elevation: D. F. 1891'

Contractor L. J. Dreiling & Sons, Inc.
Victoria, Kansas

G. R.

Casing Record
8 5/8" - - - - - 158'
5 1/2" - - - - - 3330'

Cement Record
125 sacks cement
100 sacks cement

Production:
Arbuckle

Figures Indicate Bottom of Formations

0 - 40	Surface clay
40 - 158	Shale
158 - 315	Shale
315 - 345	Shale
345 - 640	Sand
640 - 870	Red Rock
870 - 943	Red Rock
943 - 982	Anhydrite
982 - 1210	Shale
1210 - 1605	Shale
1605 - 1790	Shale & Shells
1790 - 1895	Lime & Shale
1895 - 1975	Lime
1975 - 2060	Lime
2060 - 2190	Shale & Lime
2190 - 2350	Lime & Shale
2350 - 2520	Shale
2520 - 2680	Shale & Broken Lime
2680 - 2765	Shale
2765 - 2878	Lime
2878 - 2955	Lime
2955 - 3025	Lime & Shale
3025 - 3050	Lime
3050 - 3120	Lime
3120 - 3130	Lime
3130 - 3210	Lime
3210 - 3273	Lime
3273 - 3317	Lime
3317 - 3330	Arbuckle line
3330 - 3340	Arbuckle line
3340	TD

RECEIVED
STATE CORPORATION COMMISSION

FEB 25 1963

CONSERVATION DIVISION
Wichita, Kansas

STATE OF KANSAS)
) ss.
COUNTY OF ELLIS

I, Leo F. Dreiling, of the L. J. Dreiling & Sons, Inc.,
upon oath states that the above and foregoing is a true and correct
copy of the log from the Daily Drilling Report on your Mermis No. 5.

Leo F. Dreiling
Leo F. Dreiling

Subscribed and sworn to before me this 21st day of January, 1963

Roman J. Zimmerman
NOTARY PUBLIC

My Commission Expires: August 14, 1965