


15-073-20950 00-00

STATE OF KANSAS
STATE CORPORATION COMMISSION

Form C

Give All Information Completely
Make Required Affidavit
Mail or Deliver Report to:
Conservation Division
State Corporation Commission
P. O. Box 17027
Wichita, Kansas 67217
NORTH

WELL PLUGGING RECORD

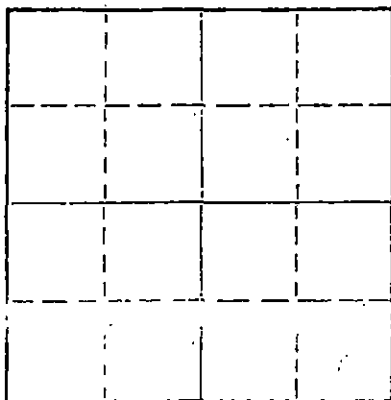

Locate well correctly on above
Section Plat

Greenwood County. Sec. 23 Twp. 22 Rge. 12 (E) (W)
Location as "NE/CNWSW" or footage from lines. 275' from E line - 275' from S line
Lease Owner R. & G Oil Co. NE 1/4
Lease Name Schwab Well No. 1
Office Address Madison, Kansas
Character of Well (completed as Oil, Gas or Dry Hole) Dry hole
Date well completed 9/8/75 19
Application for plugging filed 9/8/75 19
Application for plugging approved 9/8/75 19
Plugging commenced 9/8/75 19
Plugging completed 9/8/75 19
Reason for abandonment of well or producing formation
No producing formation found
If a producing well is abandoned, date of last production - 19
Was permission obtained from the Conservation Division or its agents before plugging was commenced? yes

Name of Conservation Agent who supervised plugging of this well Merle Hickey
Producing formation - Depth to top - Bottom - Total Depth of Well 1727 Feet
Show depth and thickness of all water, oil and gas formations.

OIL, GAS OR WATER RECORDS

CASING RECORD

FORMATION	CONTENT	FROM	TO	SIZE	PUT IN	PULLED OUT
Douglass Sand	Salt water	610	706	8"	102	0

Describe in detail the manner in which the well was plugged, indicating where the mud fluid was placed and the method or methods used in introducing it into the hole. If cement or other plugs were used, state the character of same and depth placed, from _____ feet to _____ feet for each plug set.

Filled with rotary mud from T.D. to 200' and set bridge plug and cemented with 12 sacks. Filled with mud to 40' and set bridge plug and cemented with 8 sacks. Filled rat hole and cemented with 2 sacks.

RECEIVED
STATE CORPORATION COMMISSION

SEP 19 1975

CONSERVATION DIVISION
Wichita, Kansas

9-19-75

(If additional description is necessary, use BACK of this sheet)

Name of Plugging Contractor Jackman & Jackman
Address Madison, Kansas

15 015-20980-90-02

WELL LOG

Company R & G Oil Co.
 Farm Schwab
 Well No. 1
 Location 275' from E line & 275' from S line
 NE 1/4 Sec. 23-22-12 E Greenwood County, Kansas
 Commenced 9/11/75
 Completed 9/8/75
 Casing 102' of 3" cemented with 60 sacks cement
 Contractor Jackman & Jackman
 Production D & A
 Total Depth 1727'

Soil & clay	0	20
Lime & shale	20	400
Shale & shells	400	606
Lime	606	610
Sand - water	610	706
Lime	706	935
Sandy-lime	935	966
Lime	966	975
Shale	975	1012
Lime	1012	1113
Shale & shells	1113	1198
Shale	1198	1727

0' is 4' above ground level.

RECEIVED
STATE CONSERVATION COMMISSION

SEP 18 1975

CONSERVATION DIVISION
Wichita, Kansas